


LEIBERT-McATEE & ASSOCIATES, INC. 615 S 10th AVE STERLING, CO 80751 970-522-1960

HYDROLOGY MAP

THIS MAP DOES NOT REPRESENT A BOUNDARY SURVEY

SECTION 1
TOWNSHIP 10 NORTH
RANGE 62 WEST

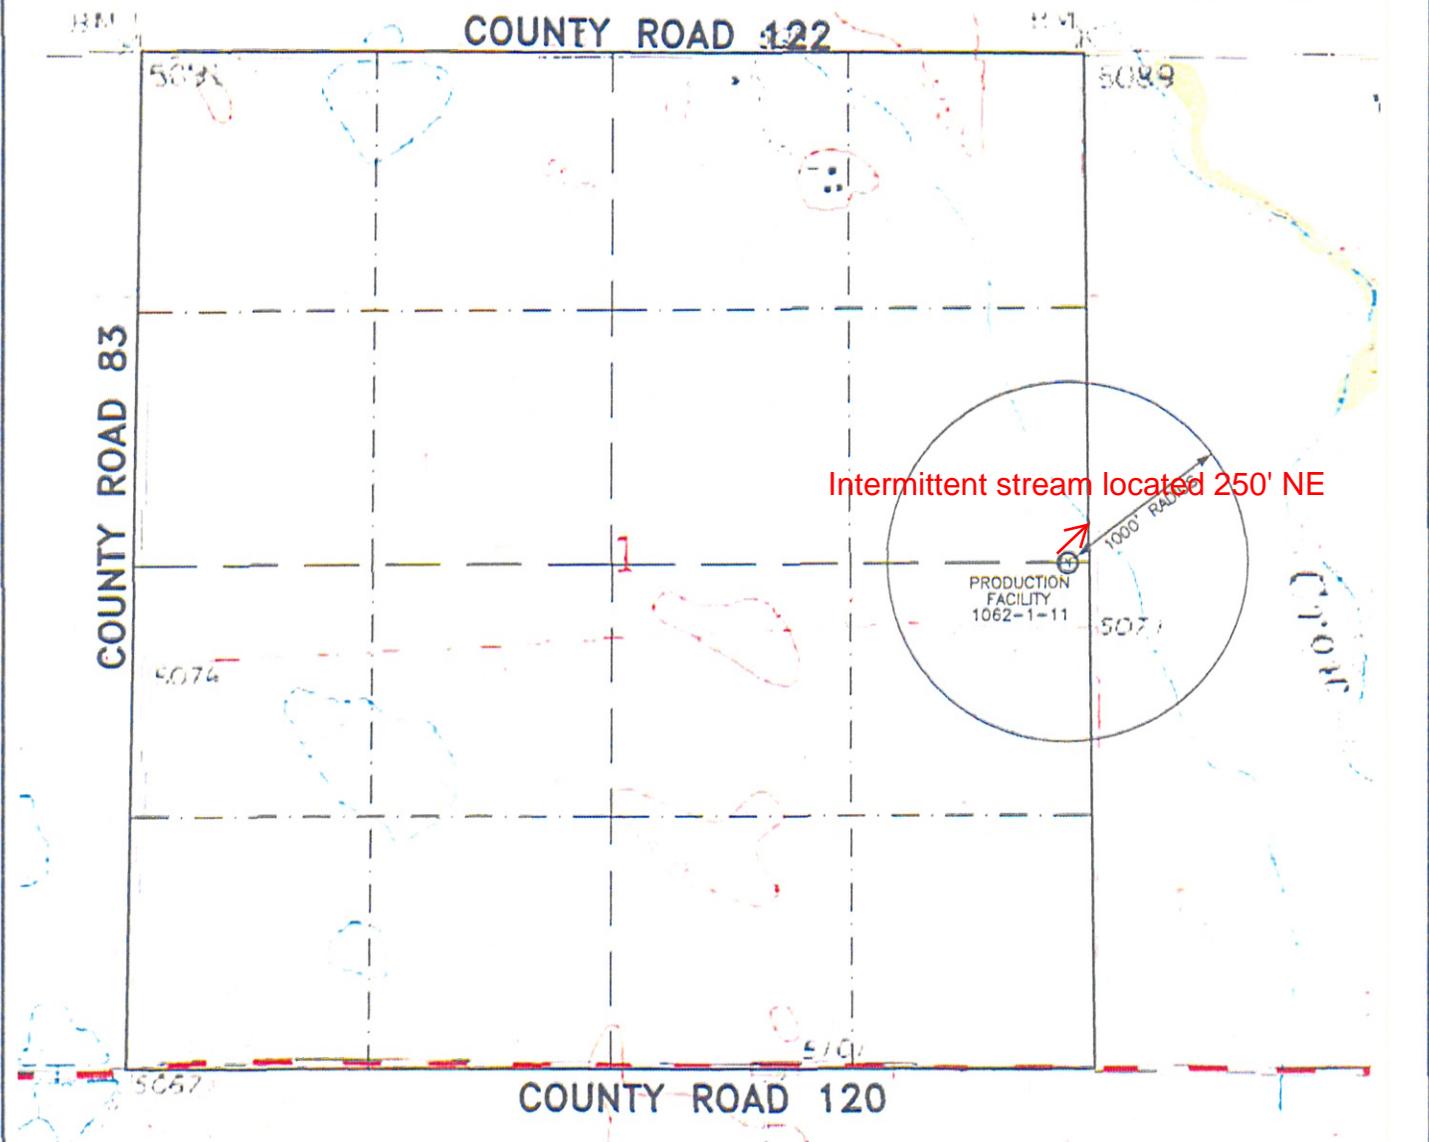

Intermittent stream located 250' NE

PRODUCTION FACILITY
1062-1-11



SCALE: 1"=1000'
0 500 1000
SCALE IN FEET

THERE IS NO VISIBLE SURFACE WATER WITHIN 1000'

DATE: 4/9/10