



T6S, R91W, 6th P.M.

BILL BARRETT CORP.

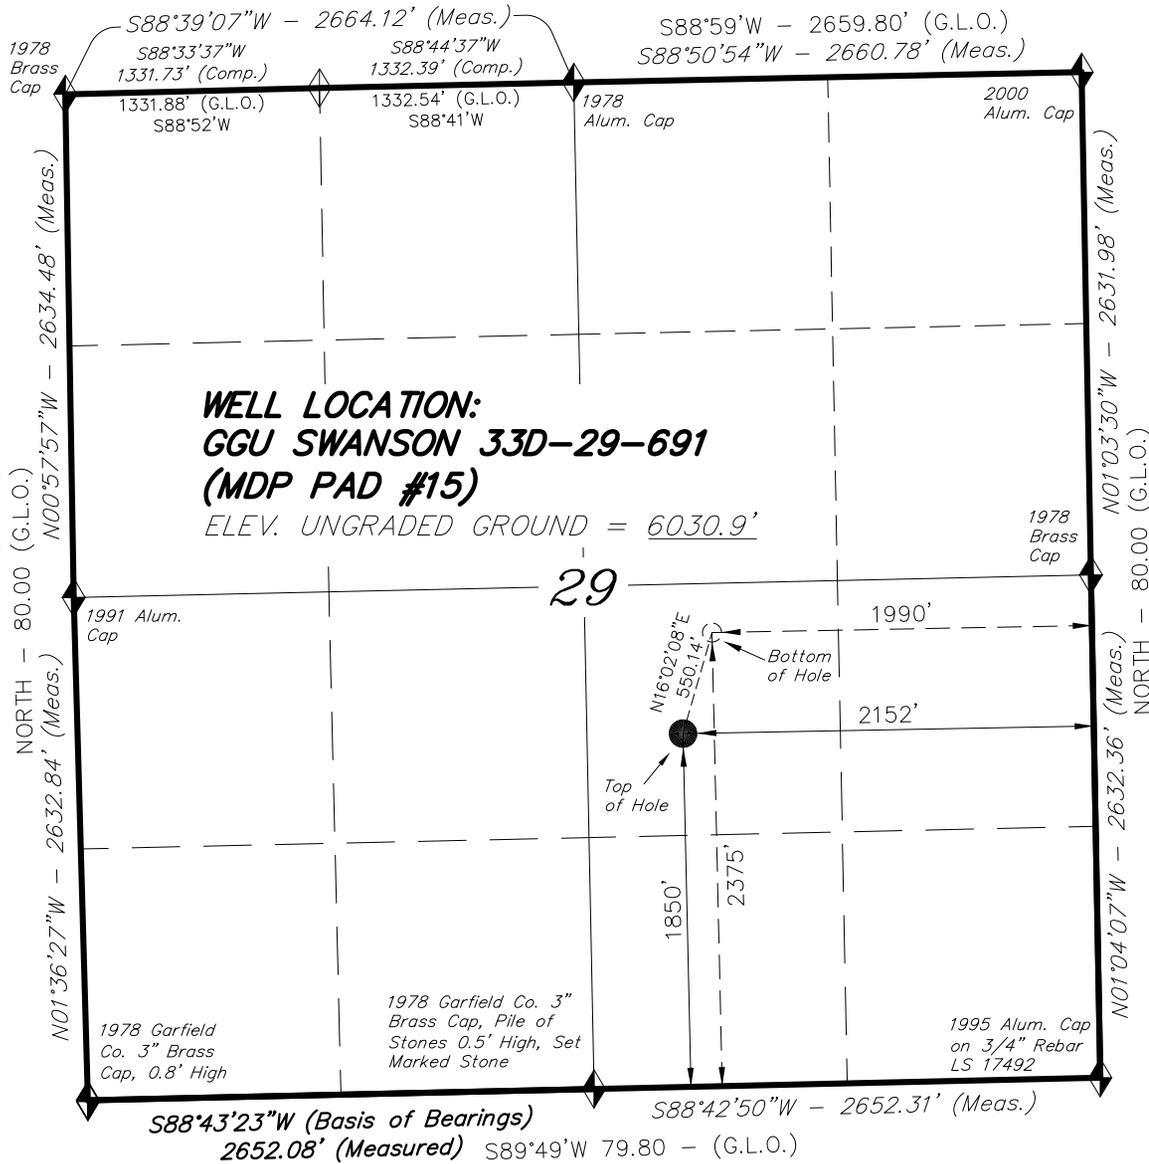

WELL LOCATION, GGU SWANSON 33D-29-691 (MDP PAD #15), LOCATED AS SHOWN IN THE NW 1/4 SE 1/4 OF SECTION 29, T6S, R91W, 6th P.M. GARFIELD COUNTY, COLORADO.

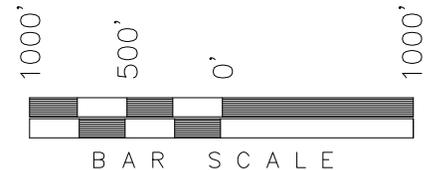

NOTES:

1. Well footages are measured at right angles to the Section Lines.
2. Bearings are based on Global Positioning Satellite observations.
3. G.P.S. Operator: D. Slauch, (PDOP) = 2.6



IMPROVEMENT NOTE:

See addendum to legal plat (sheet 2o) for existing improvements within 400' of the proposed well pad.

THIS IS TO CERTIFY THAT THE ABOVE PLAT WAS PREPARED FROM FIELD NOTES OF ACTUAL SURVEYS MADE BY ME OR UNDER MY SUPERVISION. THE LOCATION HAS BEEN STAKED ON THE GROUND AS SHOWN ON THE PLAT, AND THAT THE SAID PLAT TRULY AND CORRECTLY REPRESENTS THE SAID SURVEY TO THE BEST OF MY KNOWLEDGE AND BELIEF.

Debra C. Barrett
30125
REGISTERED LAND SURVEYOR
REGISTRATION NO. 30125
STATE OF COLORADO

NAD 83 (SURFACE LOCATION)	
LATITUDE	= 39°29'48.17" (39.496714)
LONGITUDE	= 107°34'33.73" (107.576036)

◆ = SECTION CORNERS LOCATED

Basis of elevation is the Rifle 2 Triangulation Station. 39°31'53.80" N Lat. & 107°47'07.78" W Long. (NAD 83). Elevation = 5323.1' (NAVD88).

TRI STATE LAND SURVEYING & CONSULTING		
180 NORTH VERNAL AVE. - VERNAL, UTAH 84078		
(435) 781-2501		
DATE SURVEYED: 03-23-10	SURVEYED BY: C.D.S.	SHEET 2n OF 12
DATE DRAWN: 01-06-10	DRAWN BY: F.T.M.	
REVISED: 04-15-10 - M.W.	SCALE: 1" = 1000'	