


WELL LOCATION CERTIFICATE

THIS MAP DOES NOT REPRESENT A BOUNDARY SURVEY

SECTION: 4
TOWNSHIP: 3N
RANGE: 64W

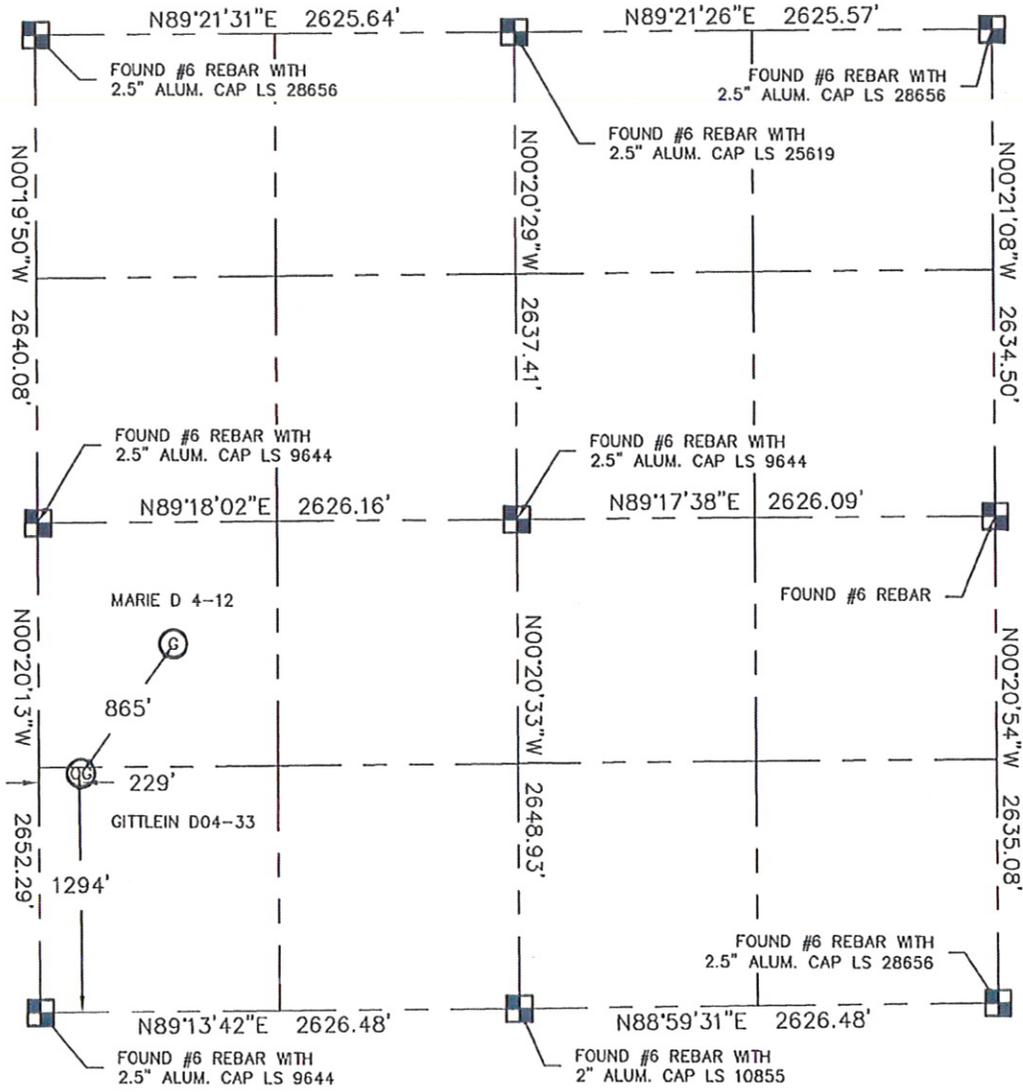

In accordance with a request from Sean Casper with Noble Energy Inc. King Surveyors Inc. has determined the surface location of the GITTLEIN D04-33 to be 1294' from the South line and 229' from the West line as measured at right angles from the section line of Section 4, Township 3 North, Range 64 West of the Sixth Principal Meridian, County of Weld, State of Colorado.

I hereby state that this Well Location Certificate was prepared by me, or under my direct supervision, that the fieldwork was completed on 2-8-10, for and on behalf of Noble Energy Inc. That this is not a Land Survey Plat or an Improvement Survey Plat, and that it is not to be relied upon for establishment of fence, building, or other future improvement lines.

NOTE:

- 1) Bearings shown are Grid Bearings of the Colorado State Plane Coordinate System, North Zone, North American Datum 1983/2007. The lineal dimensions as contained herein are based upon the "U.S. Survey Foot."
- 2) Ground elevations are based on an observed GPS elevation (NAVD 1988 DATUM).
- 3) NEAREST EXISTING WELL: MARIE D 4-12 865' NORTHEAST
- 4) IMPROVEMENTS: See VISIBLE IMPROVEMENTS exhibit for all visible improvements within 400' of well head.
- 5) SURFACE USE: GRASSLAND

SURFACE LOCATION
 LATITUDE: 40.25077°N
 LONGITUDE: 104.56461°W
 PDOP: 2.0
 ELEV: 4723
 1/4, 1/4: SW 1/4 SW 1/4
 NEAREST PROPERTY LINE: 229' WEST

NOTE
 According to Colorado law, you must commence any legal action based upon any defect in this W.L.C. within three years after you discover such defect. In no event, may any action based upon any defect in this survey be commenced more than ten years after the date of the certificate shown hereon. (13-80-105 C.R.S.)

LEGEND


- = ALIQUOT MONUMENT AS DESCRIBED
- = CALCULATED POSITION

Steven A. Lundson
 on behalf of King Surveyors, Inc.
 Licensed Land Surveyor No. 34995
 State of Colorado

PROJECT#: 2008275

SITE SKETCH

SECTION: 4
TOWNSHIP: 3N
RANGE: 64W

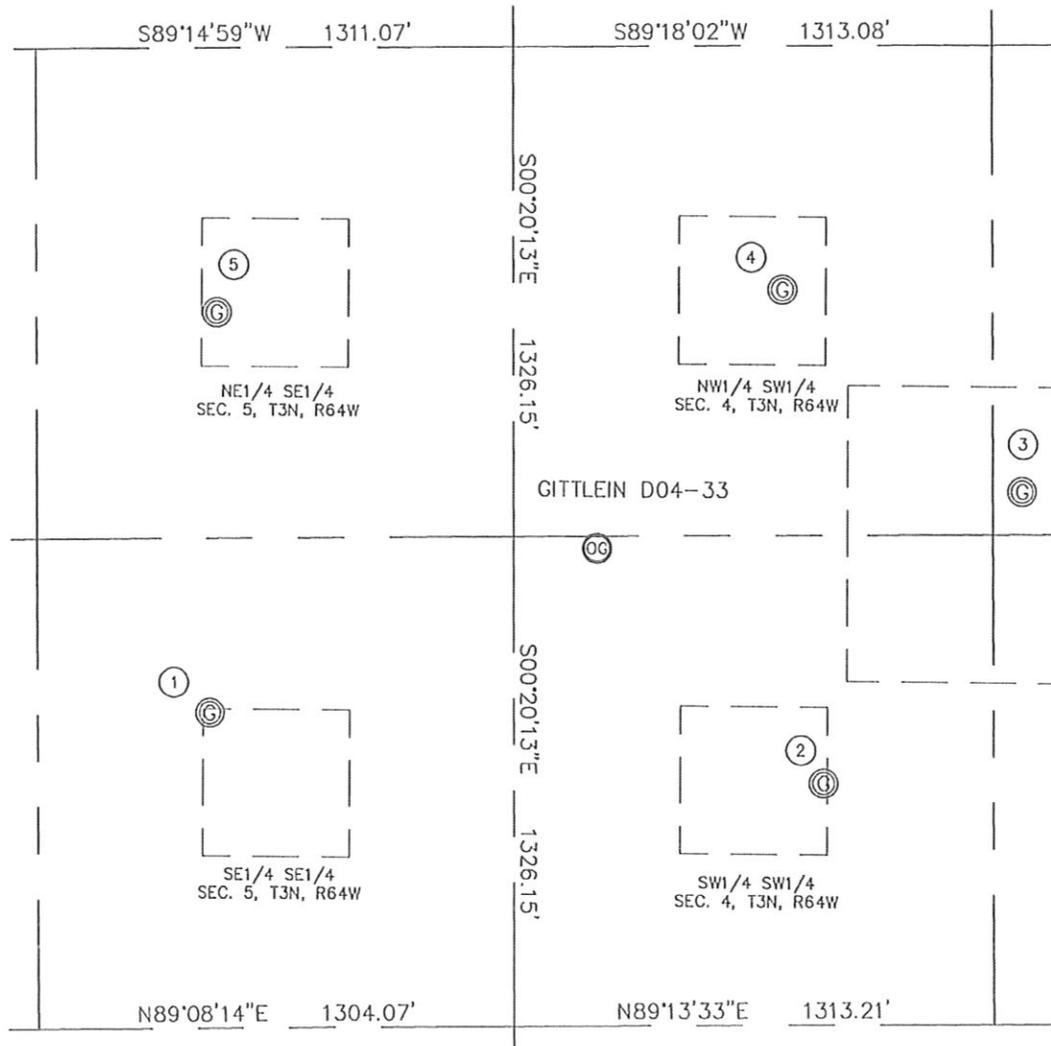

①

BECKER 5-5
SE $\frac{1}{4}$ SE $\frac{1}{4}$
855' FSL
833' FEL
LAT-40.24955°N
LONG-104.56842°W
PDOP: 1.8
ELEV: 4726

②

MARIE D 4-13
SW $\frac{1}{4}$ SW $\frac{1}{4}$
654' FSL
847' FWL
LAT-40.24902°N
LONG-104.56241°W
PDOP: 3.4
ELEV: 4722

③

MARIE D 4-25
NE $\frac{1}{4}$ SW $\frac{1}{4}$
1442' FSL
1393' FWL
LAT-40.25118°N
LONG-104.56044°W
PDOP: 2.6
ELEV: 4720

④

MARIE D 4-12
NW $\frac{1}{4}$ SW $\frac{1}{4}$
1991' FSL
738' FWL
LAT-40.25268°N
LONG-104.56277°W
PDOP: 2.7
ELEV: 4722

⑤

BECKER 5-16
NE $\frac{1}{4}$ SE $\frac{1}{4}$
1939' FSL
813' FEL
LAT-40.25252°N
LONG-104.56833°W
PDOP: 1.9
ELEV: 4743

