




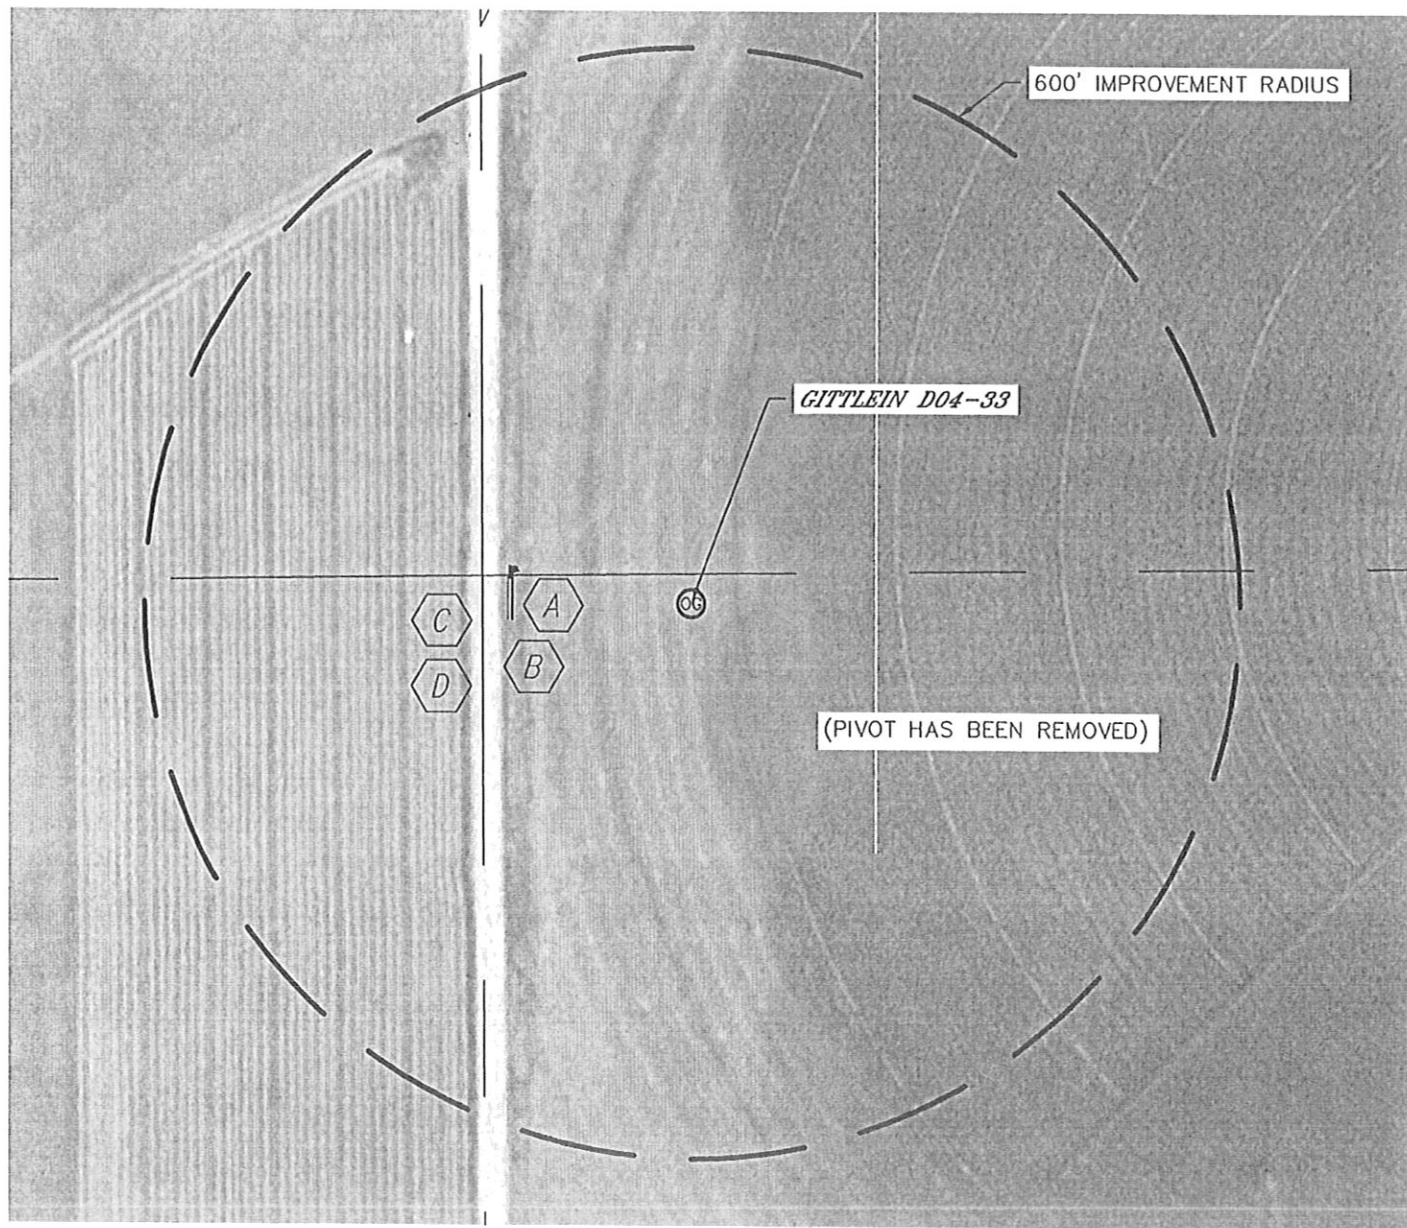

VISIBLE IMPROVEMENTS

SECTION: 4
TOWNSHIP: 3N
RANGE: 64W



IMPROVEMENTS:

-  CONCRETE DITCH 197' WEST
-  OVERHEAD UTILITY 202' WEST
-  PROPERTY LINE 229' WEST
-  CENTER COUNTY ROAD 53 229' WEST

