WELL LOCATION CERTIFICATE

SECTION 21, TOWNSHIP 4 NORTH, RANGE 67 WEST, 6TH P.M.

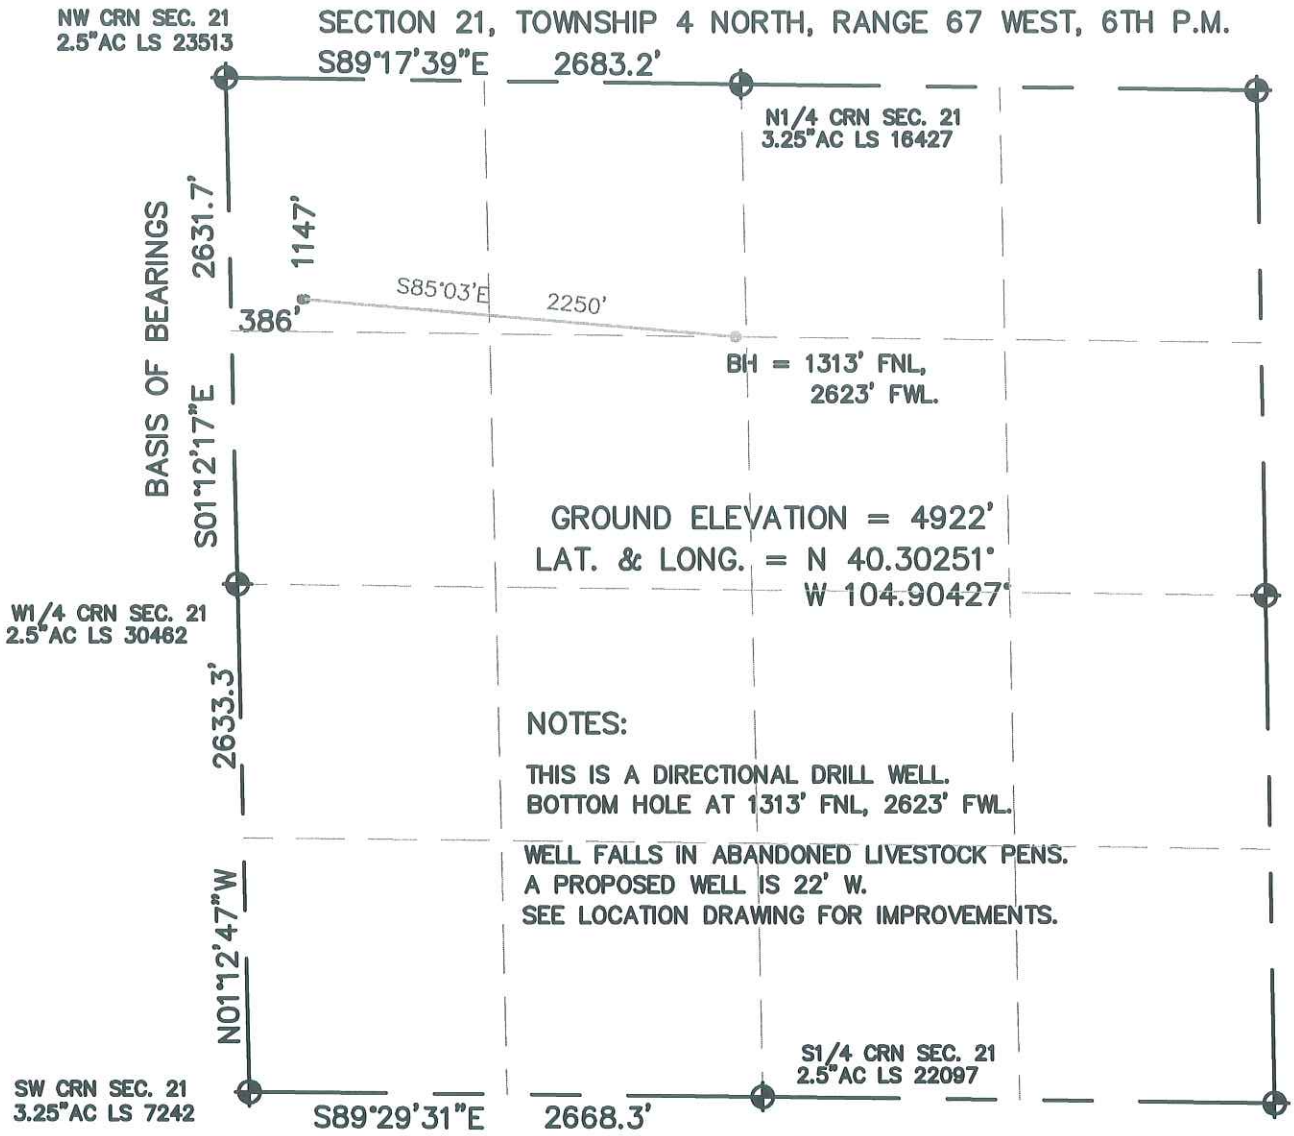

I HEREBY STATE TO UNIOIL THAT THIS WELL LOCATION CERTIFICATE FOR THE WELL EEE 21NDU IS LOCATED 1147' FNL & 386' FWL, SEC. 21, T4N, R67W, 6PM.

LEGEND

- ⊕ = FOUND MONUMENT
- • = PROPOSED WELL
- ○ = BOTTOM HOLE

NORTH

0 500 1000

SCALE 1" = 1000'

ELEVATION SOURCE = USGS 7.5' QUAD.MAP CONTOURS NGVD 1929 DATUM.

LAT. & LONG. ARE DIFFERENTIALLY CORRECTED (NAD'83) USING (DGPS) WITH (PDOP) VALUES LESS THAN SIX (6).

SHOWN DISTANCES ARE FIELD MEASURED – EXTERIOR SECTION LINES ARE DRAWN TO SCALE (BEST APPROX. OR FOUND MONUMENT ⊕).

DISTANCES TO WELL SHOWN PERPENDICULAR TO SECTION LINES.

THOMAS G. CARLSON, PLS 24657
HORSESHOE SURVEYING, LLC

THIS IS NOT A MONUMENTED BOUNDARY SURVEY, IT IS ONLY A DRAWING INTENDED TO DEPICT THE WELL LOCATION TO SECTION LINES.

PREPARED BY: HORSESHOE SURVEYING, LLC PO BOX 150458 LAKEWOOD, CO 80215 (720)872-0196		WELL NAME: EEE 21NDU	
DRAWING DATE: 1-29-10		LOCATION: WELD COUNTY, CO NW1/4, SEC. 21, T4N, R67W, 6TH P.M.	
FIELD DATE: 1-27-10	BY: TGC	CHKD:	JOB NO.	SHEET NO. 1 OF 1