


KING SURVEYORS, INC. 650 GARDEN DR. WINDSOR, CO 80550

LOCATION DRAWING

SECTION: 36
TOWNSHIP: 1S
RANGE: 45W

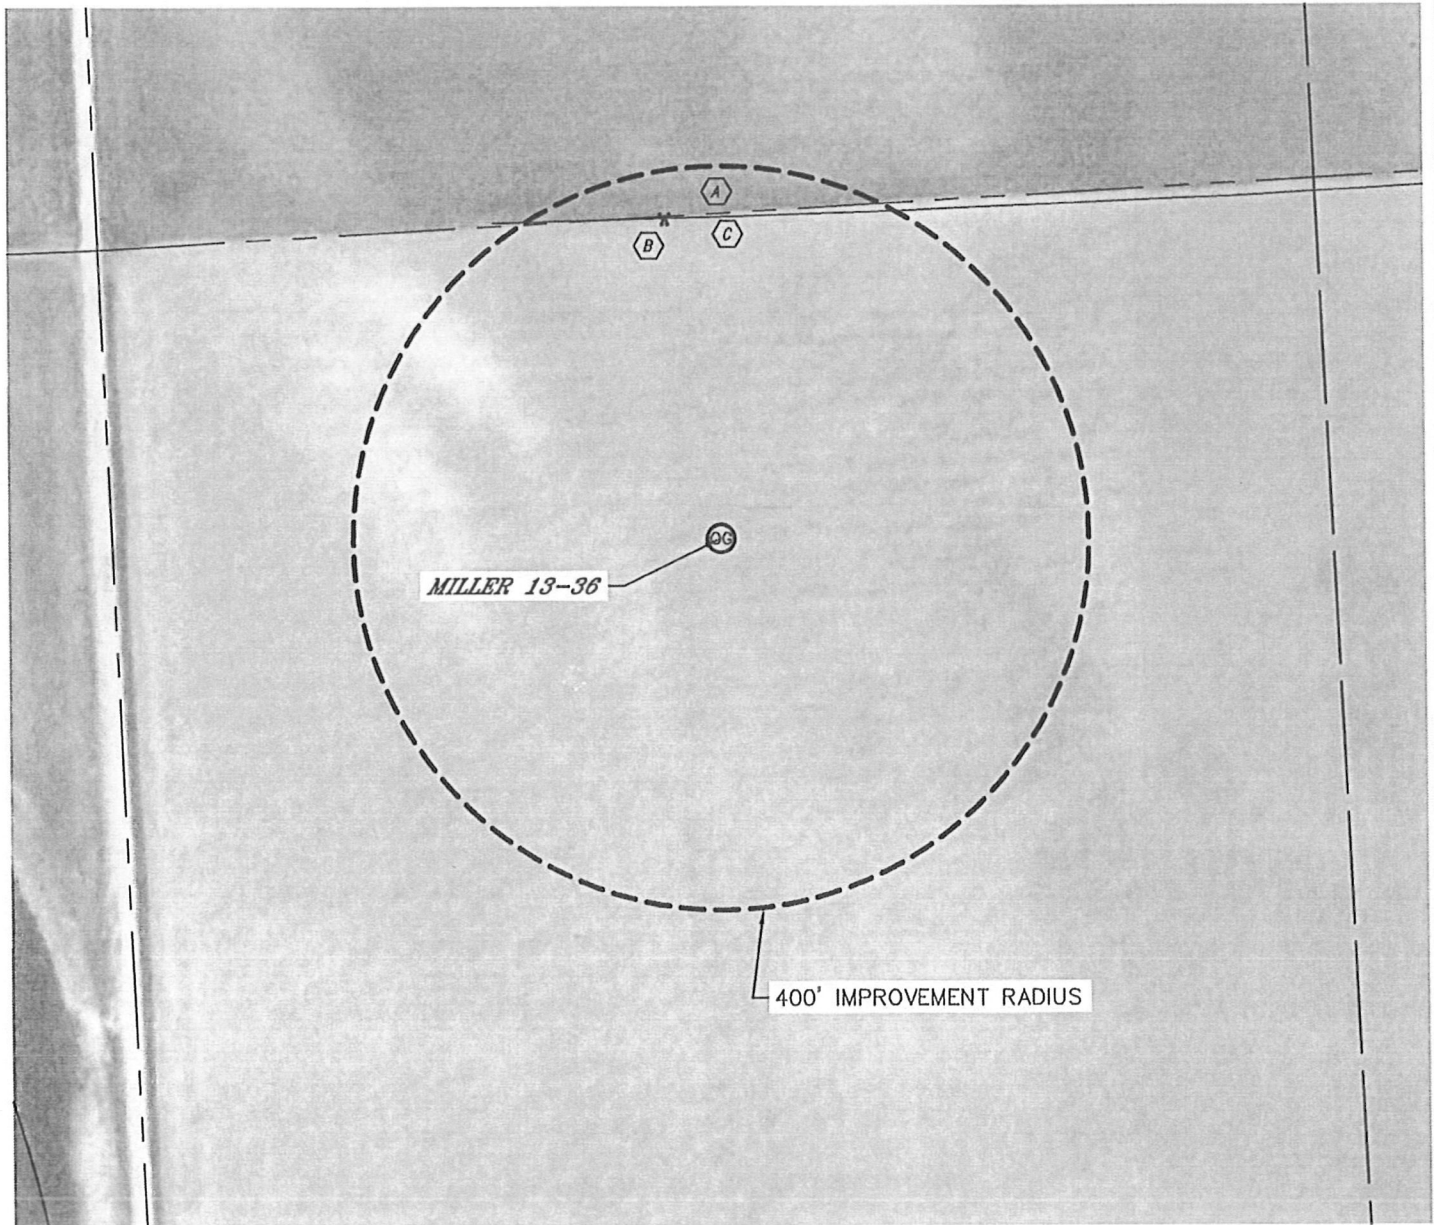

IMPROVEMENTS:

- A PROPERTY LINE 348' NORTH
- B WOOD POST 349' NORTH
- C FIELD LINE 345' NORTH



0 200
1"=200'