


# MULTI WELL PLAN

Steil Surveying Services, LLC


1102 West 19th Street P.O. BOX 2073  
SITE SKETCH

Cheyenne, Wyoming 82009

SECTION 4  
TOWNSHIP 3 NORTH  
RANGE 66 WEST

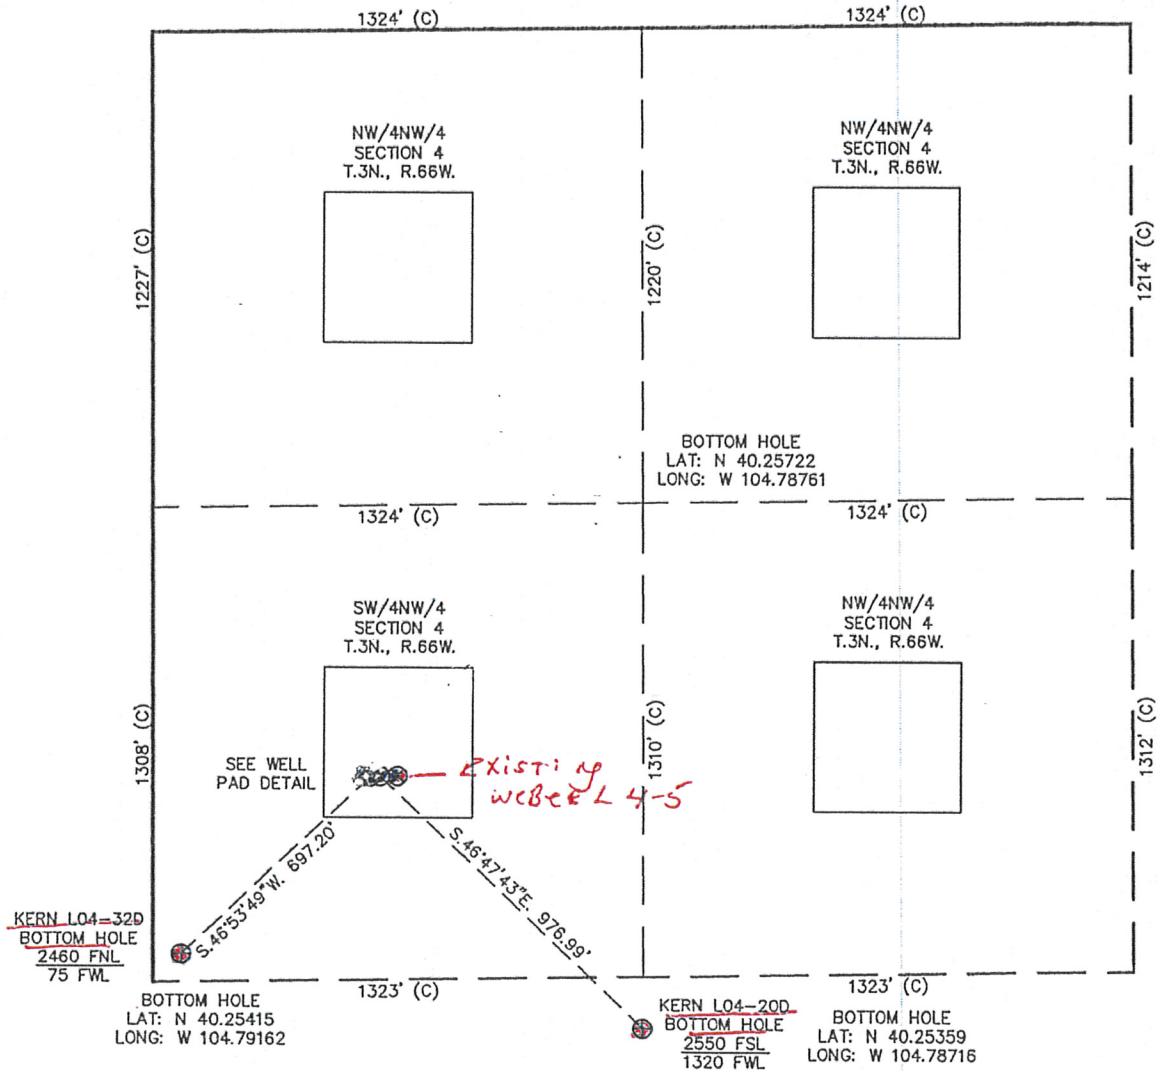

## WELL PAD DETAIL

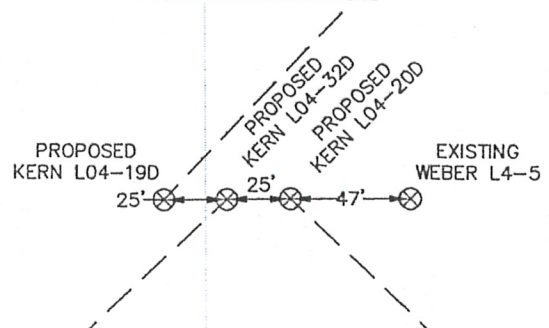

### NOTES:

- 1) THIS SKETCH DOES NOT REPRESENT A BOUNDARY SURVEY.
- 2) THE DATUM FOR THE LATITUDES AND LONGITUDES ON THIS SKETCH IS NAD83.