


COLE X6 4-8-31

WELL LOCATION

LOCATION
NE $\frac{1}{4}$ SW $\frac{1}{4}$ SEC. 31, T.5N., R.65W.

See Visible Improvements Exhibit
for all visible improvements within
200' of wellhead.


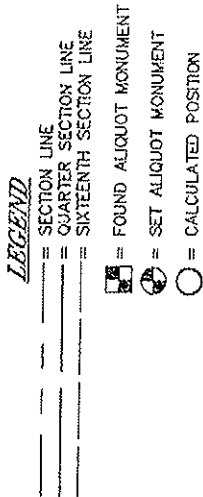


All distances to section lines
are measured perpendicular to
said section lines.


Ground elevation shown is
approximate and is based on
an observed GPS elevation
(NAVD 1988 DATUM).

Bearings shown are Grid
Bearings of the Colorado State
Plane Coordinate System,
North Zone, North American
Datum 1983/92.

King Surveyors Inc. of Windsor, Colorado has in accordance with a request from COLLIN RICHARDSON for Mineral Resources Inc. determined the surface location of COLE X6 4-8-31 to be 2605' from the South line and 1743' from the West line and the Bottom Hole to be 135' from the South line and 2558' from the East line of Section 31, Township 5 North, Range 65 West of the Sixth Principal Meridian, County of Weld, State of Colorado.

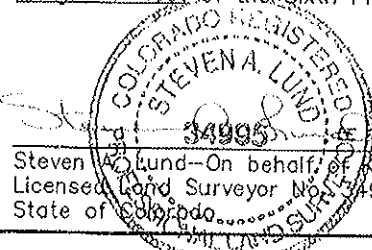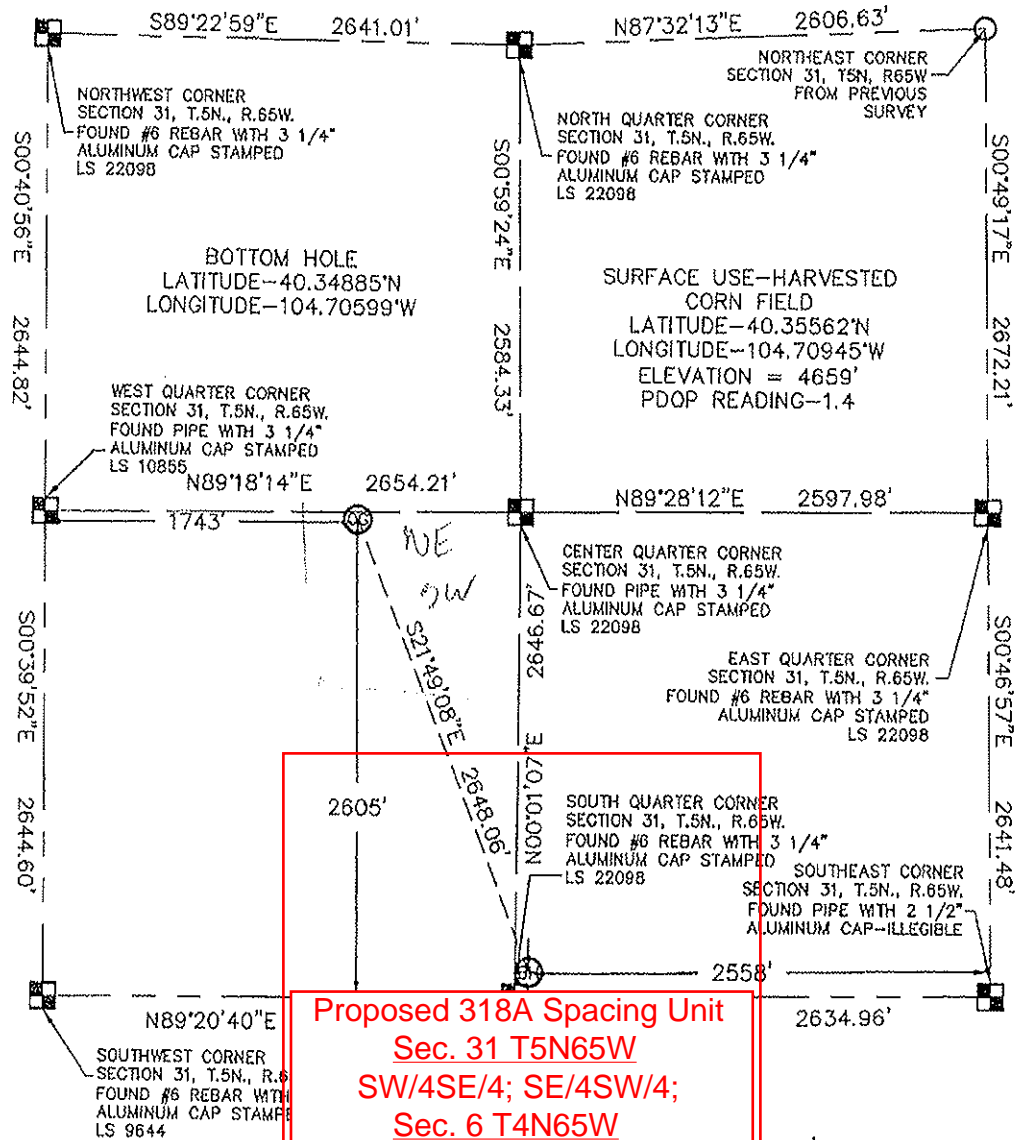

Steven A. Lund—On behalf of King Surveyors, Inc.
Licensed Land Surveyor No. 34995
State of Colorado

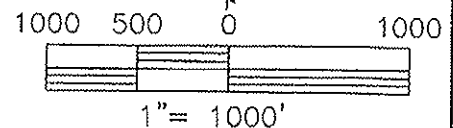

KING SURVEYORS, INC.

650 Garden Drive | Windsor, Colorado 80550

phone: (970) 686-5011 | fax: (970) 686-5821

www.kingsurveyors.com

PROJECT NO: 2007482

DATE: 10-9-08

CLIENT: MINERAL RESOURCES

DWG: 2007482WELLEXHIBIT_X

FIELD OPERATOR: DALLAS NIELSEN

DATE OF WORK: 1/11/09