


# T6S, R91W, 6th P.M.


S89°01'W - 5320.92' (G.L.O.)

**BILL BARRETT CORP.**

WELL LOCATION, JOLLEY 42B-20-691 (MDP PAD #13), LOCATED AS SHOWN IN THE NW 1/4 SE 1/4 OF SECTION 20, T6S, R91W, 6th P.M. GARFIELD COUNTY, COLORADO.

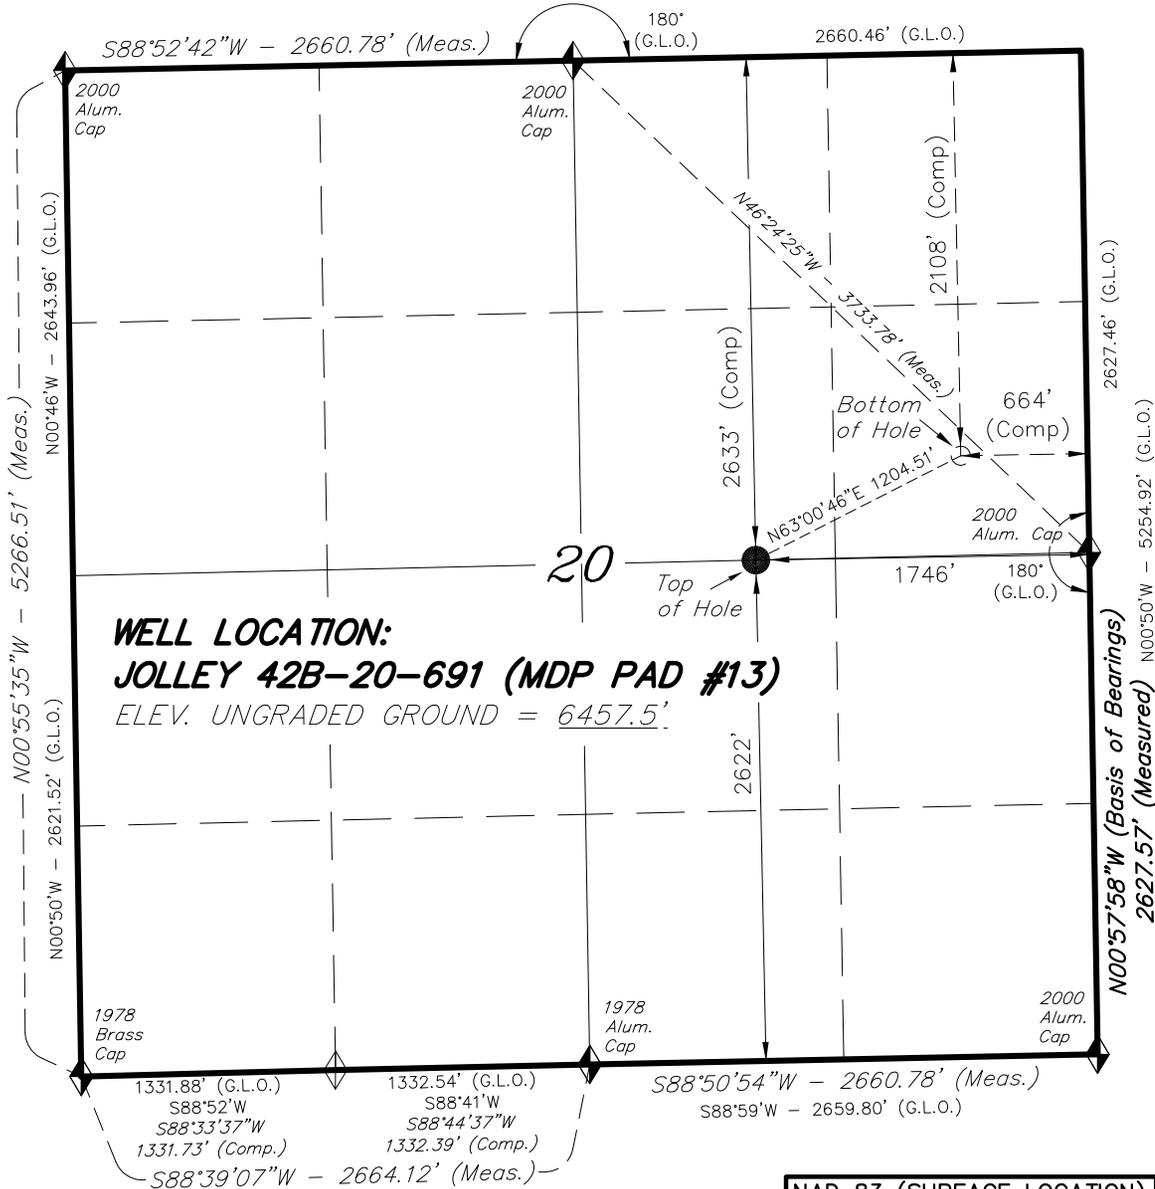

**WELL LOCATION:**  
**JOLLEY 42B-20-691 (MDP PAD #13)**  
 ELEV. UNGRADED GROUND = 6457.5'

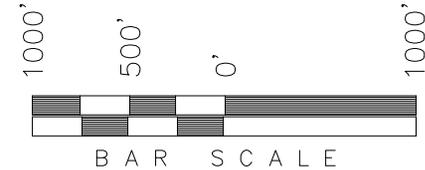

**NOTES:**

1. Well footages are measured at right angles to the Section Lines.
2. Bearings are based on Global Positioning Satellite observations.
3. The Bottom of hole bears N53°02'16" W 841.76' from the East 1/4 Corner.
4. G.P.S. Operator: D. Slauch, (PDOP) = 1.8

**IMPROVEMENT NOTE:**

See addendum to legal plat (sheet 2i) for existing improvements within 400' of the proposed well head.

THIS IS TO CERTIFY THAT THE ABOVE PLAT WAS PREPARED FROM FIELD NOTES OF SURVEYS MADE BY ME OR UNDER MY SUPERVISION. THE LOCATION HAS BEEN STAKED ON THE GROUND AS SHOWN ON THE PLAT, AND THAT THE SAME ARE TRUE AND CORRECT TO THE BEST OF MY KNOWLEDGE AND BELIEF.

*Debra L. Steinhilber*  
 # 30125  
 REGISTERED LAND SURVEYOR  
 REGISTRATION No. 30125  
 STATE OF COLORADO

NAD 83 (SURFACE LOCATION)	
LATITUDE	= 39°30'47.93" (39.513313)
LONGITUDE	= 107°34'29.76" (107.574932)

◆ = SECTION CORNERS LOCATED

Basis of elevation is the Rifle 2 Triangulation Station. 39°31'53.80" N Lat. & 107°47'07.78" W Long. (NAD 83). Elevation = 5323.1' (NAVD88).

**TRI STATE LAND SURVEYING & CONSULTING**

180 NORTH VERNAL AVE. - VERNAL, UTAH 84078  
 (435) 781-2501

DATE SURVEYED: 01-05-10	SURVEYED BY: C.D.S.	<b>SHEET 2b OF 12</b>
DATE DRAWN: 01-08-10	DRAWN BY: L.C.S.	
REVISED:	SCALE: 1" = 1000'	