Hydrology 1000' 5-25-7-45

- Red Lines
- OIL AND GAS WELLS
  - Oil and Gas Wells
  - Temporary Point
  - Permits
  - Pending Permits
  - Pending_2A_Locations
- Buffer layer
- CITIES TOWNS PLACES
  - Towns and Places
- ROADS AND RRS
  - Major Highways
  - Major Roads
  - Forest Service Roads
  - Local Roads
- WATER RESOURCES
  - Water Wells
  - Lakes
  - Major Rivers
  - Streams
- SAN JUAN BASIN

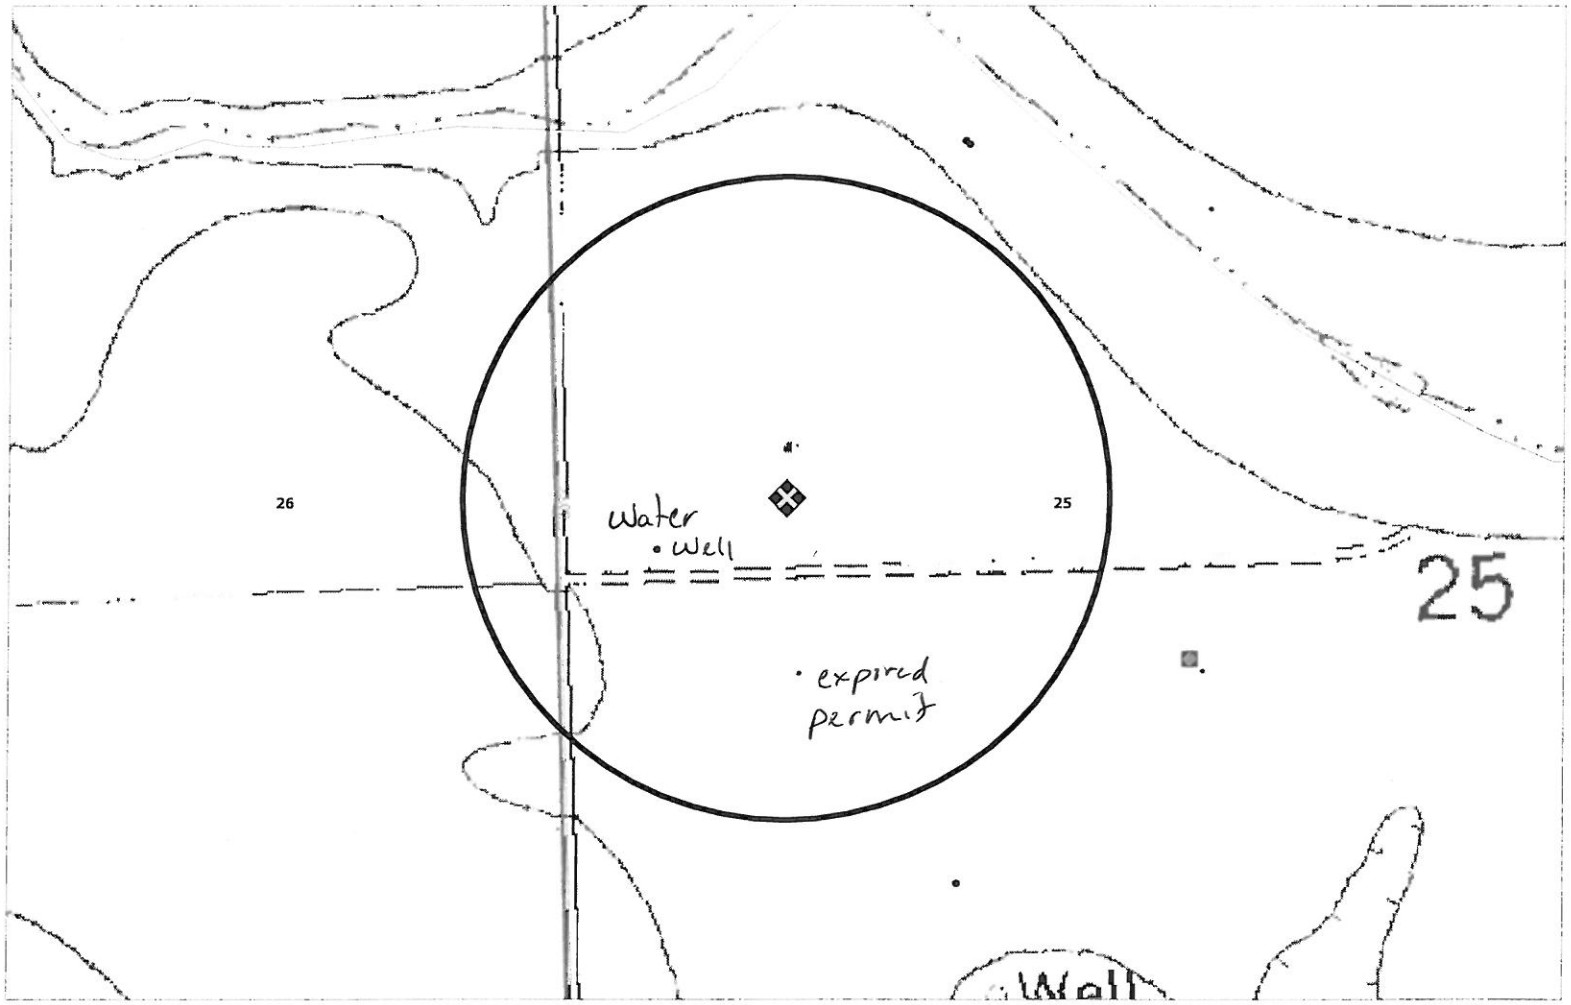

SCALE 1 : 7,141

500 0 500 1,000 1,500

FEET

No water features
w/in 1000'.

N

http://cogcc.state.co.us/infosys/maps/cogccProduction.mwf

Wednesday, May 12, 2010 4:36 PM