


Hydrology B Aerial 1000' 5-25-7-45

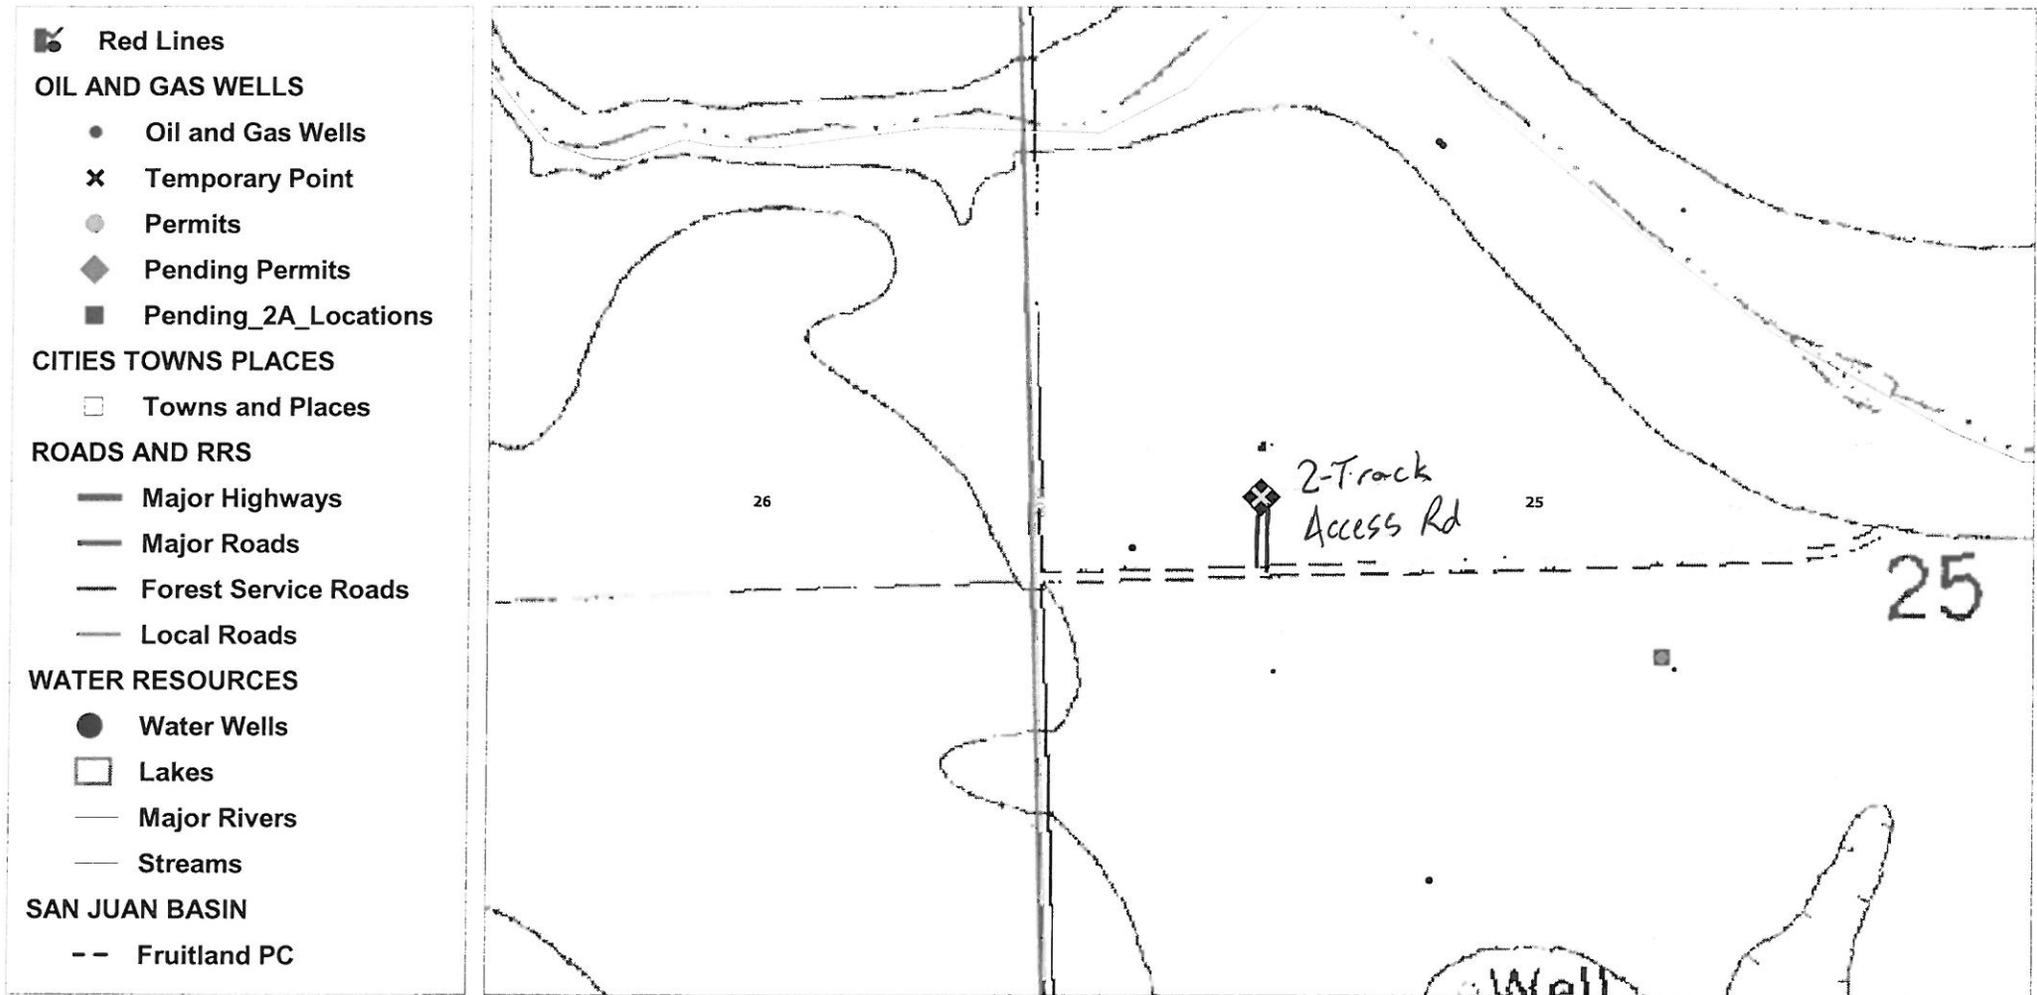

SCALE 1 : 7,141

