


Location Drawing 400'

Martin 5-25-7-45



SCALE 1 : 3,551

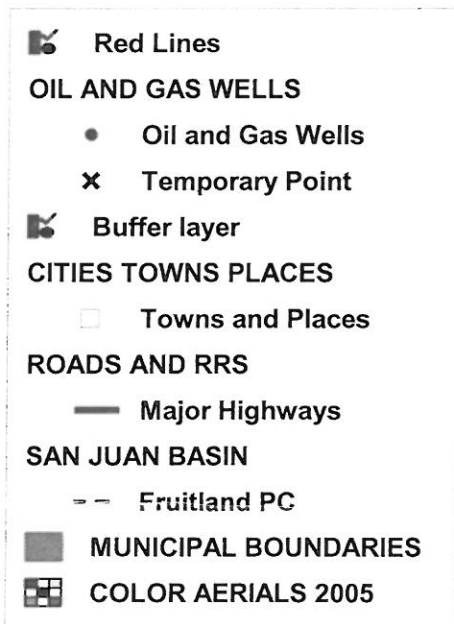

- Obstructions within 400'
- 1) Roadway 2-track dirt South 200'
 - 2) Overhead power lines South 200'
 - 3) Propane tank (above ground) West 400'

