

3258

705(F) 626

Form 18—(Producers)
Kan., Okla. & Colo., 1937

C

OIL AND GAS LEASE

Recorded on 8²⁶ June A MAY 26 1970
Ass. No. 1548047 Ass. Recorder
2-1

INDEXED

THIS AGREEMENT, Entered into this the 6th day of May 1970
between Alfred D. Sater and Lorraine R. Sater, husband and wife, Rt. 4
Box 121, Longmont, Colorado

and Martin J. Freedman, Midland Savings Bldg., Denver, Colo. hereinafter called lessor,
and Ten & more hereinafter called lessee, does witness:

1 That lessor, for and in consideration of the sum of Ten & more Dollars in hand paid and of the covenants and agreements hereinafter contained to be performed by the lessee, has this day granted, leased, and let and by these presents does hereby grant, lease, and let exclusively unto the lessee the hereinafter described land, and with the right to unite this lease or any part thereof with other oil and gas leases as to all or any part of the lands covered thereby as hereinafter provided, for the purpose of carrying on geological, geophysical and other exploratory work, including core drilling, and the drilling, mining, and operating for, producing, and saving all of the oil, gas, casinghead gas, casinghead gasoline and all other gases and their respective constituent vapors, and for constructing roads, laying pipe lines, building tanks, storing oil, building power stations, telephone lines and other structures thereon necessary or convenient for the economical operation of said land alone or jointly with neighboring lands to produce, save, take care of, and manufacture all of such substances, and for housing and boarding employees, said tract of land with any reversionary rights therein being situated in the County of Weld State of Colorado and described as follows:

Township 2 North, Range 67 West, 6th P.M.

Section 8: NE 1/4

in Section 8, Township 2 North, Range 67 West, and containing 160 acres, more or less.

2. It is agreed that this lease shall remain in full force for a term of Five (5) years from this date, and so long thereafter as oil or gas, or either of them, is produced from said land or from lands with which said land is consolidated or the premises are being developed or operated.

3. In consideration of the premises the said lessee covenants and agrees: To deliver to the credit of lessor, free of cost, in the pipe line to which lessee may connect his wells, the equal one-eighth (1/8) part of all oil produced and saved from the leased premises.

4. The lessee shall monthly pay lessor as royalty on gas marketed from each well where gas only is found, one-eighth (1/8) of the proceeds if sold at the well or if marketed by lessee off the leased premises, then one-eighth (1/8) of its market value at the well. The lessee shall pay the lessor: (a) one-eighth (1/8) of the proceeds received by the lessee from the sale of casinghead gas, produced from any oil well; (b) one-eighth (1/8) of the value, at the mouth of the well, computed at the prevailing market price, of the casinghead gas, produced from any oil well and used by lessee off the leased premises for any purpose or used on the leased premises by the lessee for purposes other than the development and operation thereof. Lessor shall have the privilege at his own risk and expense of using gas from any gas well on said land for storage and inside lights in the principal dwelling located on the leased premises by making his own connections thereto.

Where gas from a well or wells, capable of producing gas only, is not sold or used for a period of one year, lessee shall pay or tender as royalty, an amount equal to the daily rental as provided in paragraph 5; hereof payable annually on the anniversary date of this lease following the end of each such year during which such gas is not sold or used, and while said royalty is so paid or tendered this lease shall be held as a producing property under paragraph numbered two hereof.

5. If operations for the drilling of a well for oil or gas are not commenced on said land on or before the 6th day of May 1971, this lease shall terminate as to both parties, unless the lessee shall on or before said date pay or tender to the lessor or for the lessor's credit in the Ft. Lupton State Bank at Ft. Lupton, Colorado or its successor, which Bank and its successors are the lessor's agent and shall continue as the depository of any and all sums payable under this lease regardless of change of ownership in said

land or in the oil and gas or in the rentals to accrue hereunder, the sum of One Hundred Sixty & no/100 Dollars, which shall operate as a rental and over the privilege of deferring the commencement of operations for drilling for a period of one year. In like manner and upon like payments or tenders the commencement of operations for drilling may further be deferred for like periods successively. All payments or tenders may be made by check or draft of lessee or any assignee thereof, mailed or delivered on or before the rental paying date, either direct to lessor or assignee or to said depository bank and it is understood and agreed that the consideration first recited herein, the down payment, covers not only the privilege granted to the date when said first rental is payable as aforesaid, but also the lessee's option of extending that period as aforesaid and any and all other rights conferred. Lessee may at any time exercise said option, or place of record, a release or releases covering any portion or portions of the above described premises and thereby surrender this lease as to such portion or portions and be relieved of all obligations as to the acreage surrendered, and thereafter the rentals payable hereunder shall be reduced in the proportion that the acreage covered herein is reduced by said release or releases.

6. Should the first well drilled on the above described land be a dry hole, then, and in that event, if a second well is not commenced on said land within twelve months from expiration of the last rental period for which rental has been paid, this lease shall terminate as to both parties, unless the lessor on or before the expiration of said twelve months shall resume the payment of rentals in the same amount and in the same manner as hereinbefore provided. And it is agreed that upon the resumption of the payment of rentals, as above provided, that the last preceding paragraph hereof, governing the payment of rentals and the effect thereof shall continue in force just as though there had been no interruption in the rental payments.

7. If said lessor owns a less interest in the above described land than the entire and undivided fee simple estate therein, then the royalties and rentals herein provided shall be paid the lessor only in the proportion which his interest bears to the whole and undivided fee. However, such rental shall be increased at the next succeeding rental anniversary after any reversion occurs to cover the interest so acquired.

8. The lessee shall have the right to use, free of cost, gas, oil and water found on said land for its operations thereon, except water from the wells of the lessor. When required by lessor, the lessee shall bury its pipe lines below plow depth and shall pay for damage caused by its operations to growing crops on said land. No well shall be drilled nearer than 200 feet to the house or barn now on said premises without written consent of the lessor. Lessee shall have the right at any time during, or after the expiration of, this lease to remove all machinery, fixtures, houses, buildings and other structures placed on said premises, including the right to draw and remove all casing. Lessee agrees, upon the completion of any well as a dry hole or upon the abandonment of any producing well, to restore the premises to their original contour as near as practicable and to remove all installations within a reasonable time.

9. If the estate of either party hereto is assigned (and the privilege of assigning in whole or in part is expressly allowed), the covenants herein shall extend to the heirs, devisees, executors, administrators, successors, and assigns, but no change of ownership in the land or in the rentals or royalties or any sum due under this lease shall be binding on the lessee until it has been furnished with either the original recorded instrument of conveyance or a duly certified copy thereof or a certified copy of the will of any deceased owner or of the probate thereof, or verified copy of the proceedings showing appointment of an administrator for the estate of any deceased owner, whichever is appropriate, together with all original recorded instruments of conveyance or duly certified copies thereof, necessary in showing a complete chain of title back to lessor to the full interest claimed, and all advance payments of rentals made hereunder before receipt of said documents shall be binding on any direct or indirect assignee, grantee, devisee, administrator, executor, or heir of lessor.

10. It is hereby agreed that in the event this lease shall be assigned as to a part or as to parts of the above described land and the holder or owner of any such part or parts shall make default in the payment of the proportionate part of the rent due from him or them, such default shall not operate to defeat or affect this lease insofar as it covers a part of said land upon which the lessee or any assignee hereof shall make due payment of said rentals.

11. Lessor hereby warrants and agrees to defend the title to the land herein described and agrees that the lessee, at its option, may pay and discharge in whole or in part any taxes, mortgages, or other liens existing, levied, or assessed on or against the above described lands and, in event it exercises such option, it shall be subrogated to the rights of any holder or holders thereof and may reimburse itself by applying to the discharge of any such mortgage, tax or other lien, any royalty or rentals accruing hereunder.

12. Notwithstanding anything in this lease contained to the contrary, it is expressly agreed that if lessee shall commence operations for drilling at any time while this lease is in force, this lease shall remain in force and its terms shall continue so long as such operations are prosecuted and, if production results therefrom, then so long as production continues.

If within the primary term of this lease, production on the leased premises shall cease from any cause, this lease shall not terminate provided operations for the drilling of a well shall be commenced before or on the next ensuing rental paying date; or, provided lessee begins or resumes the payment of rentals in the manner and amount hereinbefore provided. If, after the expiration of the primary term of this lease, production on the leased premises shall cease from any cause, this lease shall not terminate provided lessee resumes operations for re-working or drilling a well within sixty (60) days from such cessation and this lease shall remain in force during the prosecution of such operations and, if production results therefrom, then so long as production continues.

13. Lessee is hereby expressly granted the right and privilege (which Lessee may exercise at any time either before or after production has been obtained upon this premises or any premises consolidated herewith) to consolidate the gas leasehold estate created by the execution and delivery of this lease, or any part or parts thereof, with any other gas leasehold estate or estates to form one or more gas operating units of not to exceed approximately 800 acres each. If such operating unit or units to be created by Lessee, Lessor agrees to accept and shall receive out of the gas production from each such unit such portion of the gas royalty as the number of acres out of this lease placed in such unit bears to the total number of acres included in such unit. The commencement or completion of a well, or the continued operation or production of gas from an existing well on any portion of an operating unit shall be considered as the commencement or completion of a well, or the continued operation of, or production of gas from a well on each and all of the lands within and comprising such operating unit; provided, that the provisions of this paragraph shall not affect the payment or non-payment of delay rentals with respect to portions of this premises not included in the unit, but this lease as to such portions of this premises not included in a unit, shall be deemed to be a separate lease. In the event portions of the above described lands are included in several units, each portion so included shall constitute a separate lease, and the particular owner or owners of the lands under each separate lease shall execute in writing and record in the conveyance records of the county in which the land herein leased is situated an instrument identifying and describing the consolidated acreage.

14. This lease and all its terms, conditions and stipulations shall extend to, and be binding on each of the parties who sign this lease, regardless of whether such lessor is named above and regardless of whether it is signed by any of the other parties herein named as lessor. This lease may be signed in counterparts each to have the same effect as the original.

IN WITNESS WHEREOF, we sign the day and year first above written.

Witness:
Alfred D. Sater
Alfred D. Sater
Lorraine R. Sater
Lorraine R. Sater

MAY-26-70 00045 2691548047 9 - - -

1248047

346

626


1548047

STATE OF Colorado } ss. ACKNOWLEDGMENT FOR INDIVIDUAL (Kans., Okla., and Colo.)
COUNTY OF Weld

Before me, the undersigned, a Notary Public, within and for said county and state, on this
day of May 1970, personally appeared Alfred H. Salter
and Joseph R. Salter

to me personally known to be the identical person who executed the within and foregoing instrument and acknowledged to me
that they executed the same as free and voluntary act and deed for the uses and purposes therein set forth.
IN WITNESS WHEREOF, I have hereunto set my hand and official seal the day and year last above written.

My commission expires _____

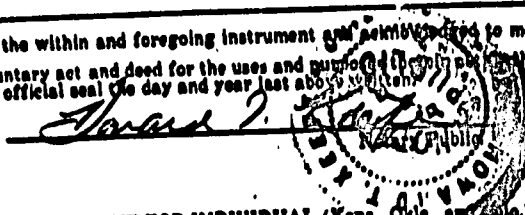

STATE OF _____ } ss. ACKNOWLEDGMENT FOR INDIVIDUAL (Kans., Okla., and Colo.)
COUNTY OF _____

Before me, the undersigned, a Notary Public, within and for said county and state, on this
day of _____ 19____, personally appeared _____
and _____

to me personally known to be the identical person who executed the within and foregoing instrument and acknowledged to me
that _____ executed the same as _____ free and voluntary act and deed for the uses and purposes therein set forth.
IN WITNESS WHEREOF, I have hereunto set my hand and official seal the day and year last above written.

My commission expires _____

Notary Public.

STATE OF _____ } ss. ACKNOWLEDGMENT FOR CORPORATION
COUNTY OF _____

On this _____ day of _____, A. D., 19____, before me, the undersigned, a Notary Public
in and for the county and state aforesaid, personally appeared _____
to me personally known to be the identical person who signed the name of the maker thereof to the within and foregoing
instrument as its _____ President and acknowledged to me that _____ executed the same as _____ free and
voluntary act and deed, and as the free and voluntary act and deed of said corporation, for the uses and purposes therein set forth.

Given under my hand and seal the day and year last above written.

My commission expires _____

Notary Public.

No. 1548047

OIL AND GAS LEASE

FROM

TO

Date _____ 19____

Section _____ Twp _____ Rgt _____

No. of Acres _____ Term _____

County _____

STATE OF _____

County of _____

This instrument was filed for record on the

day of MAY 26 1970

at 826 o'clock A. M., and duly recorded

in Book 626 Page _____

the records of this office.

By Alfred H. Salter Notary of Deeds.

Nelle M. Salter

When recorded, return to _____

NOTE: When signature by mark in Kansas, said mark to be witnessed by at least one person and also acknowledged.
For acknowledgment by mark, see regular Kansas acknowledgment.

STATE OF _____ } ss. ACKNOWLEDGMENT FOR INDIVIDUAL (Kans., Okla., and Colo.)
COUNTY OF _____

Before me, the undersigned, a Notary Public, within and for said county and state, on this
day of _____ 19____, personally appeared _____
and _____

to me personally known to be the identical person who executed the within and foregoing instrument and acknowledged to me
that _____ executed the same as _____ free and voluntary act and deed for the uses and purposes therein set forth.
IN WITNESS WHEREOF, I have hereunto set my hand and official seal the day and year last above written.

My commission expires _____

Notary Public.


9 1548047 26-5-70

265

ese

NOTARY PUBLIC


INVESTOR

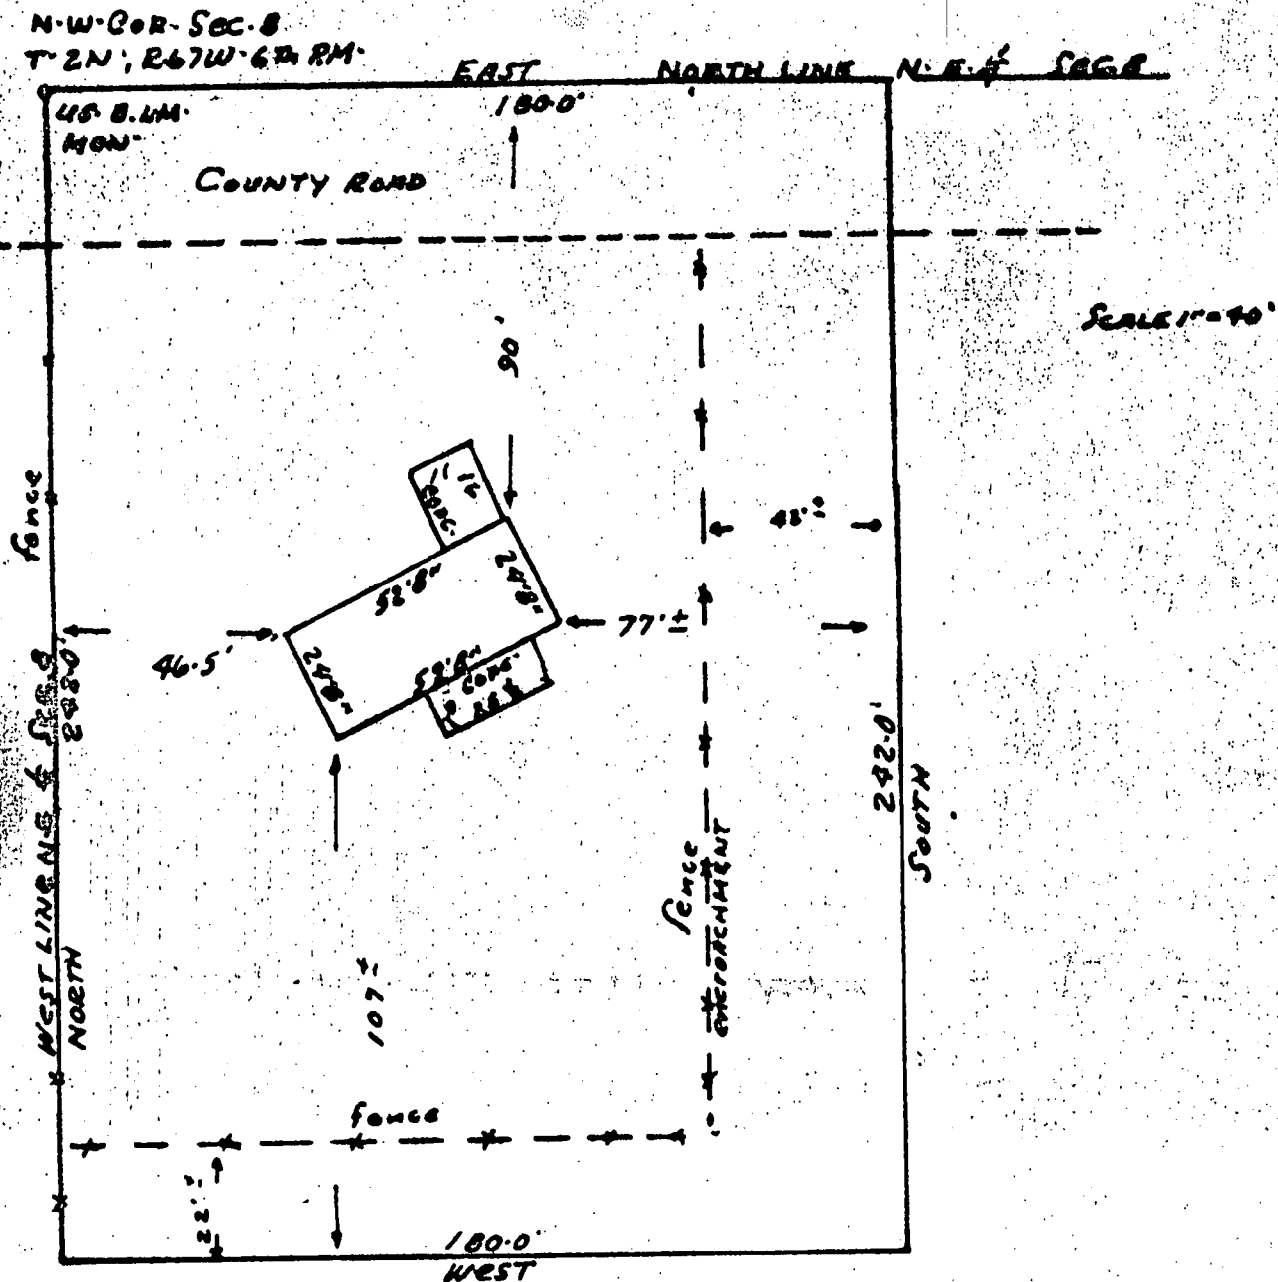

This is to certify that a survey of a tract of land 1 acre more or less, situated in the Northeast 1/4 of Section 8, T. 2 N., R. 67 W. of the 6th P.M., Weld County, Colorado, described as follows, beginning at the North-west corner of the Northeast 1/4 of said Sec. 8, thence East 180.0 feet along the North line of said Sec. 8, thence South 242.0 feet parallel to the West line of said Northeast 1/4, thence West 180.0 feet parallel to the North line of said Sec. 8, thence North 242.0 feet along the West line of the Northeast 1/4 of said Sec. 8 to the point of beginning. A one story brick residence under construction is entirely within the boundary lines of the above described property as shown on this plat, the location and dimensions of all buildings, improvements, easements, easements, rights of way in evidence or known to me and encroachments by or on the premises are accurately shown.

Was made under my supervision according to the recorded deed thereof on the 1st. day of March 1971.

Glen H. Overton

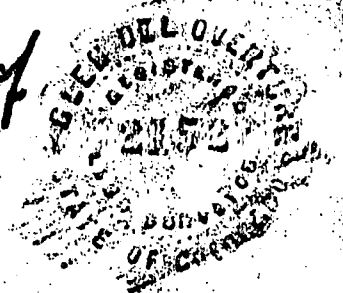

A/

Kenneth A. Ross, Jr.