



ACCESS ROAD MAP

SECTION 4
TOWNSHIP 11 NORTH
RANGE 61 WEST

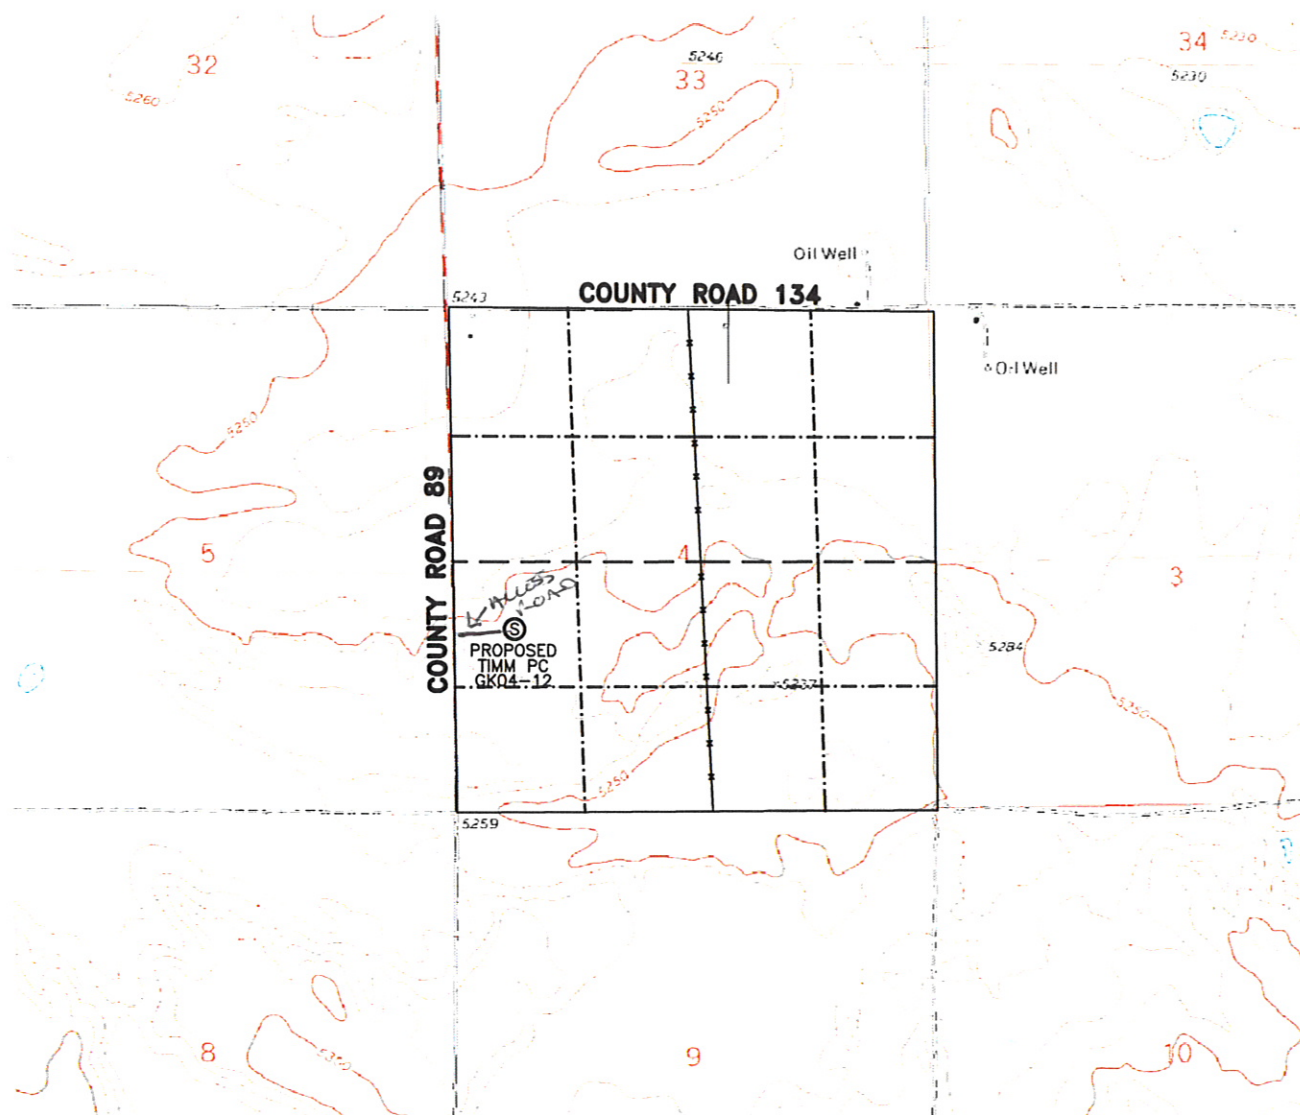

SCALE: 1"=2000'

0 1000 2000

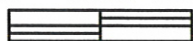

SCALE IN FEET