


PRODUCTION FACILITY VISIBLE IMPROVEMENTS SKETCH MOSER H28-24

SECTION 28, TOWNSHIP 3 NORTH, RANGE 65 WEST OF THE 6TH PRINCIPAL MERIDIAN

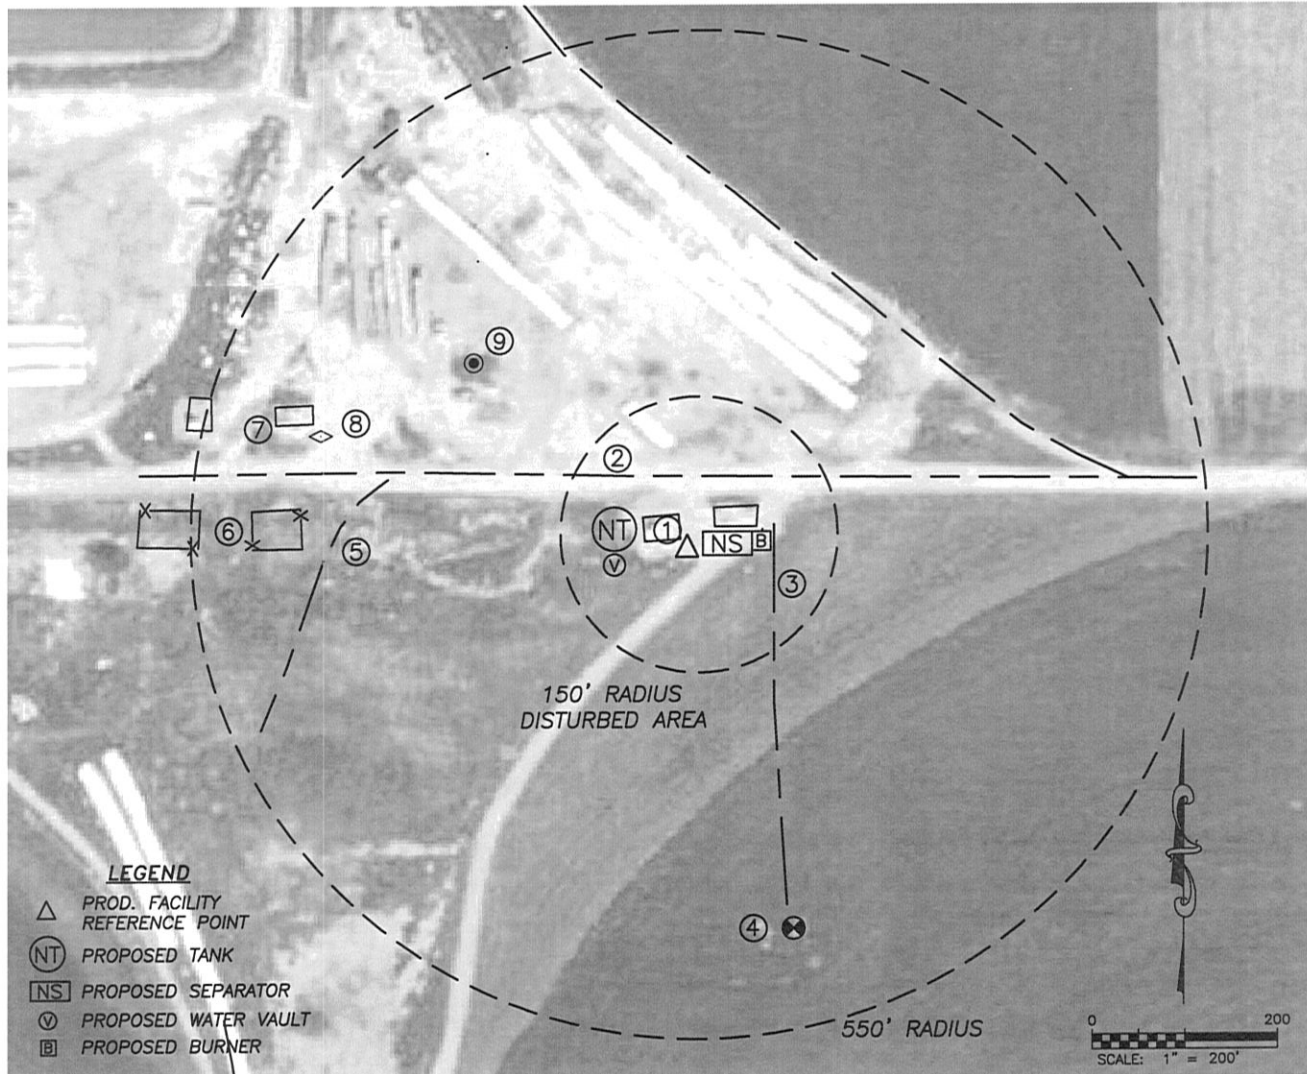

REFERENCE POINT LOCATION:

LATITUDE: N40.19632°
LONGITUDE: W104.66744°
PDOP. 2.1

ASSOCIATED EXISTING WELLS:

CANNON LAND 28-10J
CANNON LAND 28-15J

ASSOCIATED NEW WELLS:

MOSER H28-24

- | | | | |
|--|---|---|---|
| ①
<u>PROD. FACILITY</u>
30'± W | ②
<u>CENTERLINE FIELD ROAD</u>
60'± N | ③
<u>CENTERLINE FIELD ROAD</u>
70'± E | ④
<u>WELL CANNON LAND 28-10J</u>
440'± SE |
| ⑤
<u>CENTERLINE FIELD ROAD</u>
390'± W | ⑥
<u>PROD. FACILITY</u>
455'± W | ⑦
<u>PROD. FACILITY</u>
460'± NW | ⑧
<u>GAS LINE MARKER</u>
385'± NW |
| ⑨
<u>MONITOR WELL</u>
310'± NW | | | |