


VISIBLE IMPROVEMENTS SKETCH MOSER H28-24

SECTION 28, TOWNSHIP 3 NORTH, RANGE 65 WEST OF THE 6TH PRINCIPAL MERIDIAN

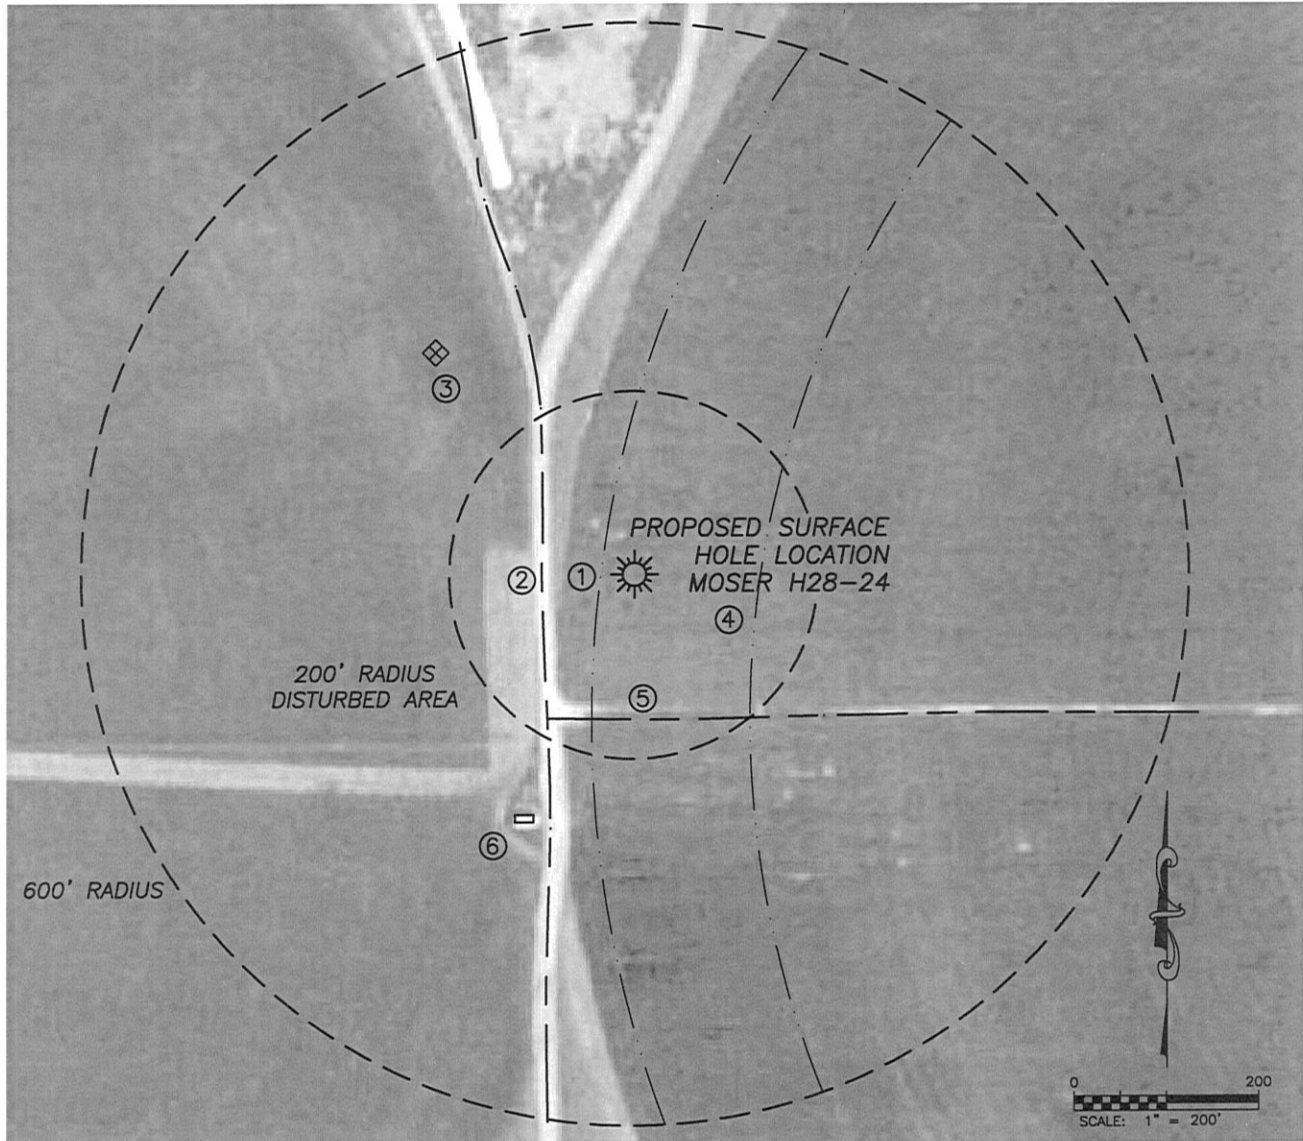

①
PIVOT TRACK
36'± W

②
CENTERLINE
FIELD ROAD
100'± W

③
OLD PIVOT
BROKEN
325'± NW

④
PIVOT TRACK
137'± E

⑤
CENTERLINE
FIELD ROAD
157'± S

⑥
WOOD BUILDING
275'± SW

NEAREST OVERHEAD POWER 1530'± S