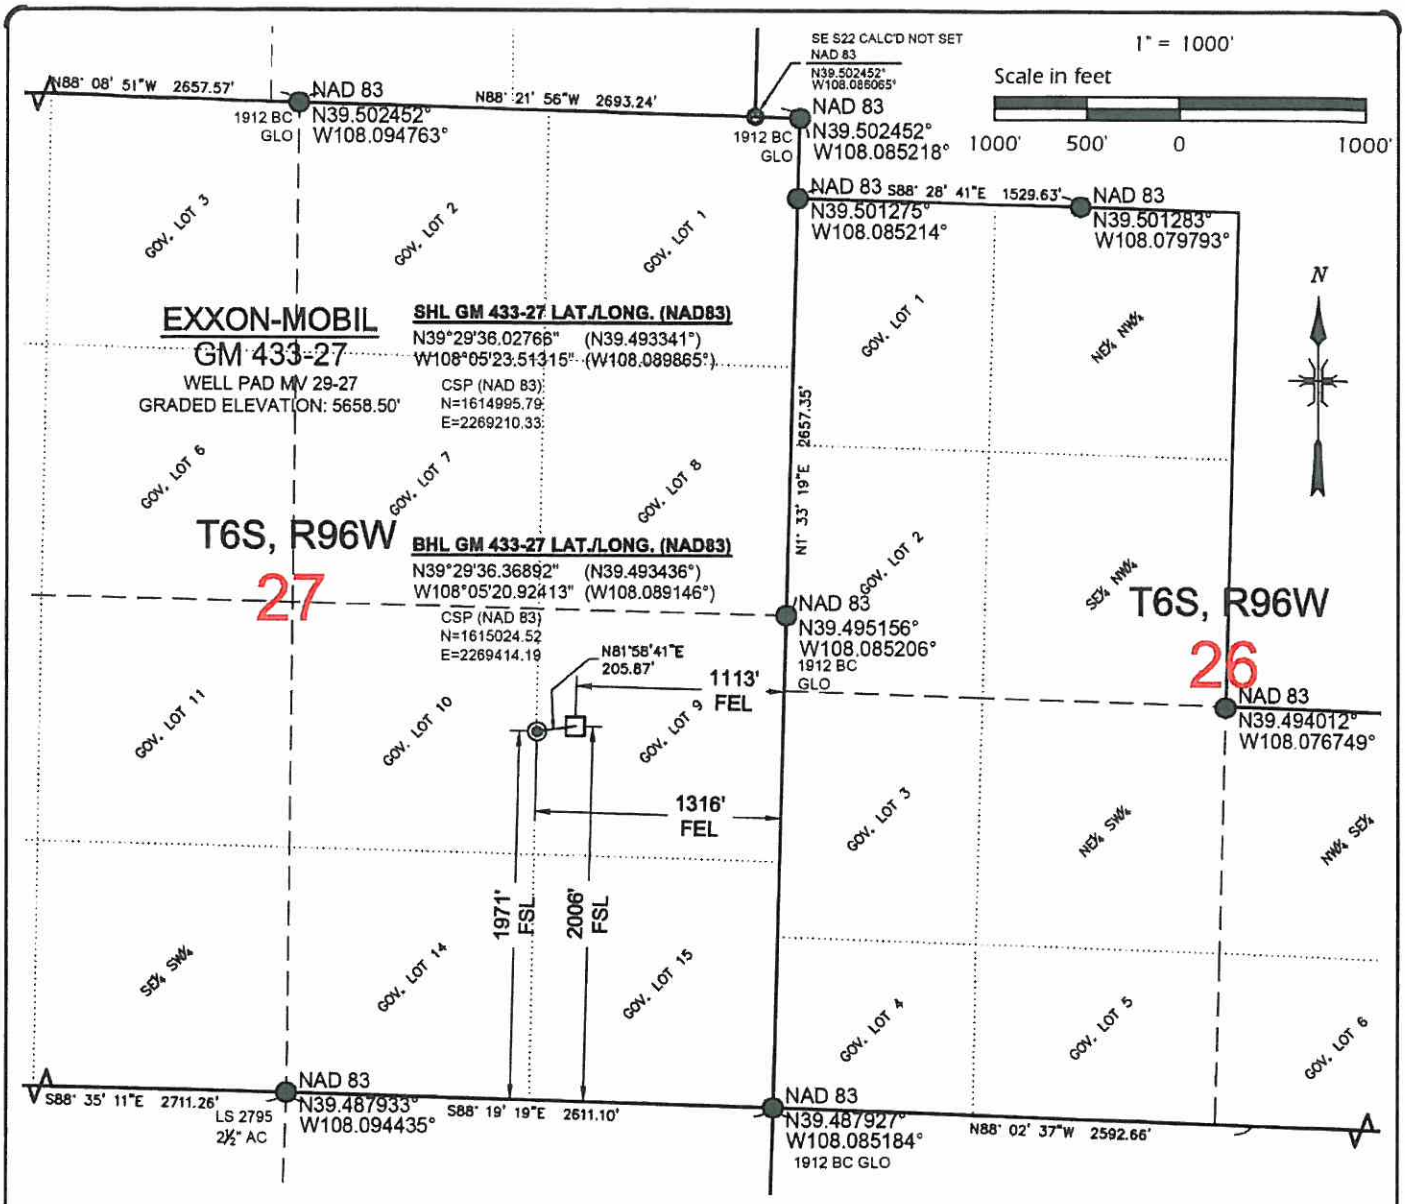

LEGEND

- FOUND MONUMENT
- CALCULATED MONUMENT
- WELL LOCATION
- BOTTOM HOLE

SHL - SURFACE HOLE LOCATION
BHL - BOTTOM HOLE LOCATION
BC - BRASS CAP
AC - ALUMINUM CAP
GLO - GENERAL LAND OFFICE SURVEY

NOTES:

1) GPS OPERATOR KURT R. SHEPHERD OBSERVED A PDOP OF 1.9
2) ALL GPS OBSERVATIONS ARE IN COMPLIANCE WITH COGCC RULE 215.
3) ALL DISTANCES ARE SPC (SEA LEVEL)
4) THIS PLAT COMPLIES WITH COGCC RULE 303c.
5) NO VISIBLE IMPROVEMENTS WITHIN 400' OF WELL HEAD.
6) VEGETATION: SCRUB OAK, SAGE, NATIVE SHRUBS & GRASSES

BASIS OF BEARING/DATUM

A GPS OBSERVATION FROM NGS PID AJ3465 (FABER)

BASIS OF ELEVATION

A GPS OBSERVATION FROM NGS PID AJ3465 (FABER). SAID ELEVATION IS 5186.22'.

DIMENSIONAL TIES

ALL DIMENSIONAL TIES TO SECTION LINES ARE MEASURED AT A 90° ANGLE TO THE SECTION LINE.

SURVEYORS CERTIFICATE:

This is to certify that this exhibit was prepared and location as shown was staked on the ground from actual surveys made by me or under my direct supervision.

COLORADO REGISTERED PROFESSIONAL LAND SURVEYOR
KURT R. SHEPHERD
28662

Kurt R. Shepherd 4-26-2010
Kurt R. Shepherd L.S. 28662
On behalf of Del-Mont Consultants Inc.

DEL-MONT CONSULTANTS IS PROVIDING GRADING DESIGN FOR THIS PROJECT THAT PROVIDES DIMENSIONS AND VOLUME INFORMATION FOR CONSTRUCTION.

DEL-MONT CONSULTANTS, INC.
ENGINEERING • SURVEYING • PLANNING

DESIGNED BY	MGW
SCALE	1"=1000'
CHECKED BY	KS
FILE NAME	10030C-MV29-27_PAD-SITE

Williams

S26 & S27, T6S, R96W, 6TH P.M.
WELL LOCATION PLAT
WELL PAD MV 29-27
GM 433-27
GARFIELD COUNTY, CO
WILLIAMS PRODUCTION, RMT

DMC JOB NO	10030
DATE ISSUED	2010-04-23
DATE SURVEYED	2008-11-17
PLAT	1 of 9