


WELL LOCATION CERTIFICATE

THIS MAP DOES NOT REPRESENT A BOUNDARY SURVEY

SECTION 13
TOWNSHIP 11 NORTH
RANGE 62 WEST

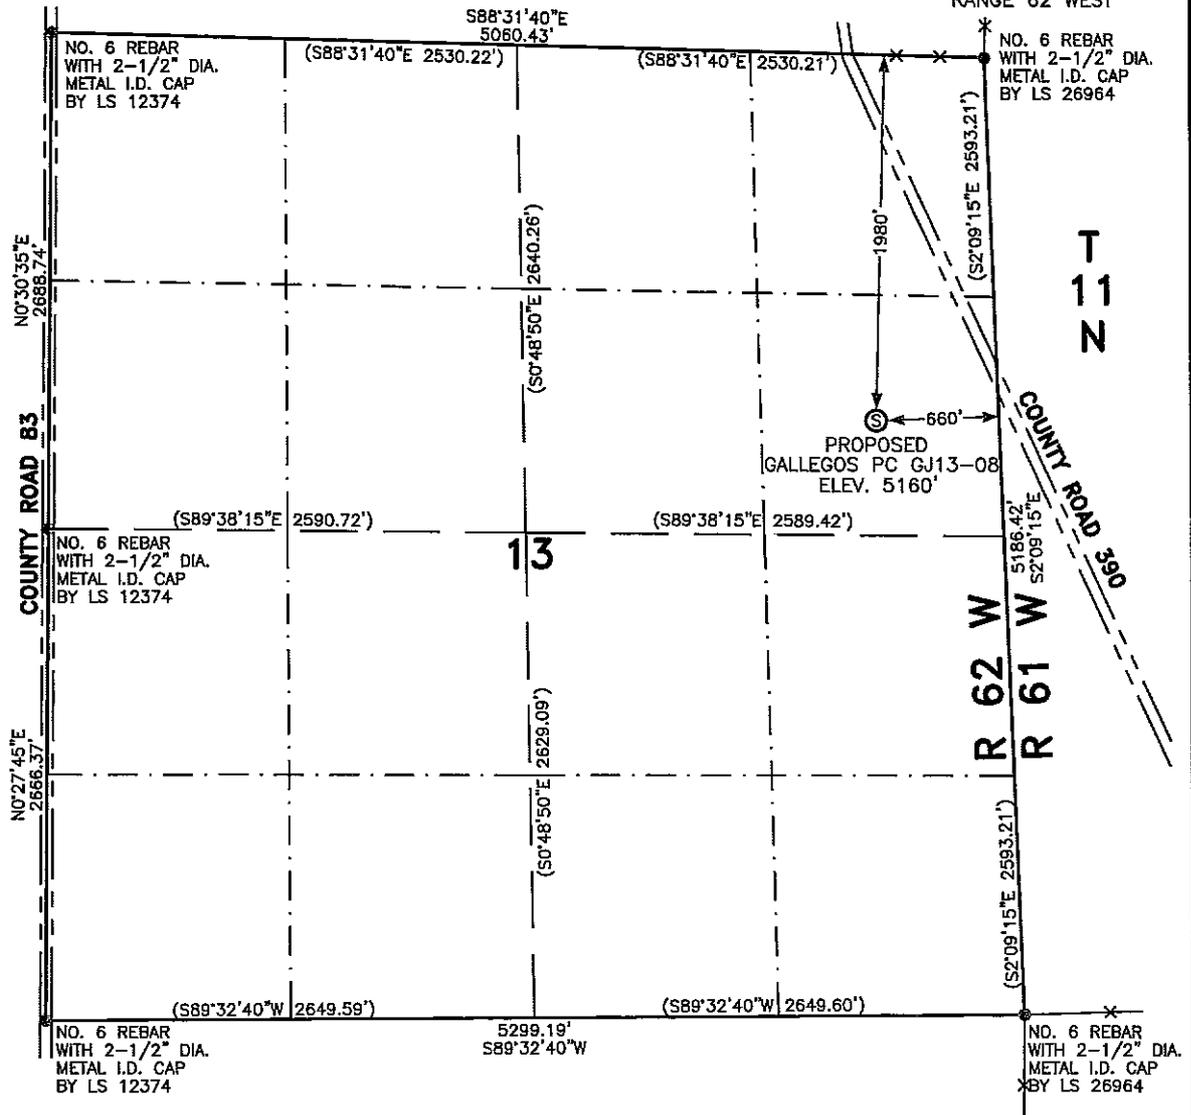

SCALE: 1"=1000'

0 500 1000



SCALE IN FEET

IN ACCORDANCE WITH A REQUEST FROM RYAN ANTONIO - NOBLE ENERGY INC. LEIBERT-McATEE & ASSOCIATES, INC HAS DETERMINED THE LOCATION OF THE GALLEGOS PC GJ13-08 WELL TO BE 1980' FNL AND 660' FEL, AS MEASURED AT NINETY (90) DEGREES FROM THE SECTION LINES OF SECTION 13, TOWNSHIP 11 NORTH, RANGE 62 WEST, 6TH PRINCIPAL MERIDIAN, WELD COUNTY, COLORADO.

I HEREBY CERTIFY THAT THIS WELL LOCATION CERTIFICATE WAS PREPARED BY ME, OR UNDER MY DIRECT SUPERVISION, THAT THE FIELD WORK WAS COMPLETED ON 4/23/2010, FOR AND ON BEHALF OF NOBLE ENERGY INC, THAT IT IS NOT A LAND SURVEY PLAT OR AN IMPROVEMENT SURVEY PLAT, AND THAT IT IS NOT TO BE RELIED UPON FOR ESTABLISHMENT OF FENCE, BUILDING, OR OTHER FUTURE IMPROVEMENT LINES.

NOTES:

- 1) BASIS OF BEARINGS FOR THIS MAP ARE BASED UPON GPS OBSERVATIONS MADE ON 4/23/2010 BETWEEN MONUMENT LOCATED AT THE NORTHWEST SECTION CORNER AND THE NORTHEAST SECTION CORNER OF SAID SECTION AND WITH ALL BEARINGS SHOWN HEREON RELATIVE THERETO.
- 2) ELEVATIONS ARE BASED UPON NGS OPUS SOLUTION NAVD 88 DATUM.
- 3) SEE VISIBLE IMPROVEMENTS EXHIBIT FOR ALL IMPROVEMENTS WITHIN 600'.
- 4) THE LOCATION FALLS IN PASTURE.

LATITUDE & LONGITUDE (NAD 83):
 LATITUDE: N 40.92388
 LONGITUDE: W 104.26164
 PDOP: 3.5
 QUARTER-QUARTER: SE1/4NE1/4
 NEAREST PROPERTY LINE: 688' NORTHEAST



LEGEND

⊙ PROPOSED SURFACE LOCATION

== == == ROAD

-x-x- FENCE

CALCULATED DIMENSIONS ARE IN PARENTHESES

GPS OPERATOR: DARREN VEAL
 DWG NO. 306-10


NOTICE: According to Colorado law you MUST commence any legal action based upon any defect in the W.L.C. within three years after you first discover such defect. In no event may only action based upon any defect in this W.L.C. be commenced more than ten years from this sold date of the certification shown hereon.

COMPLETED 4-26-10
 NICOLE F. HAY
 FOR AND ON BEHALF OF
 LEIBERT-McATEE & ASSOCIATES, INC
 P.L.S. 38044

SITE SKETCH - GALLEGOS PC GJ13-08

SECTION 13
TOWNSHIP 11 NORTH
RANGE 62 WEST

R 62 W

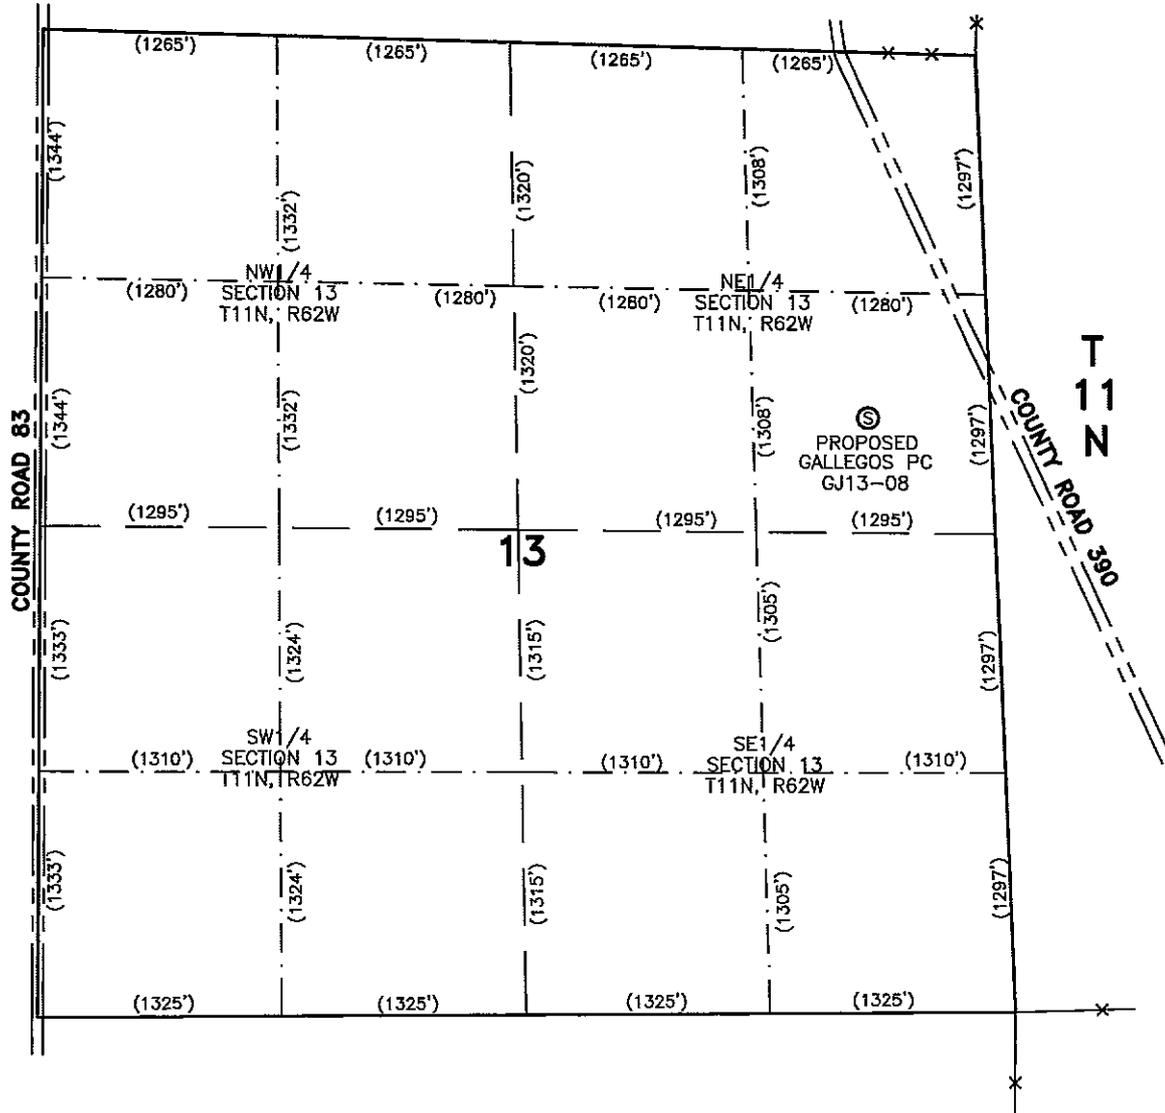

NOTES:
1) THIS SKETCH DOES NOT REPRESENT A BOUNDARY SURVEY.



SCALE: 1"=1000'
0 500 1000

SCALE IN FEET

LEGEND
 (S) PROPOSED SURFACE LOCATION
 == == == ROAD
 - x - x - FENCE
 CALCULATED DIMENSIONS
 ARE IN PARENTHESES