

## PROPOSED 318Ae SPACING UNIT

Steil Surveying Services, LLC


1102 West 19th Street P.O. BOX 2073

Cheyenne, Wyoming 82009

## TION CERTIFICATE

## PRESENT A BOUNDARY SURVEY

SECTION 1  
TOWNSHIP 3 NORTH  
RANGE 64 WEST

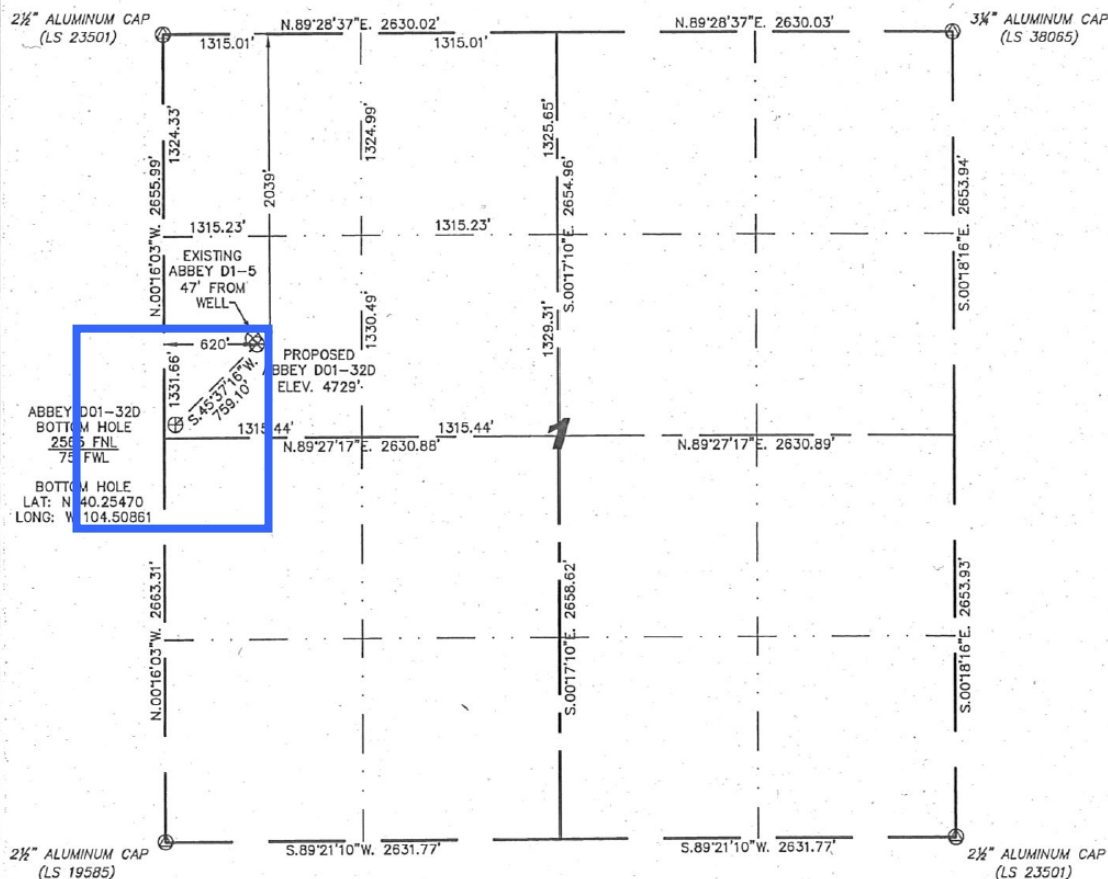

0 1000  
Scale: 1" = 1000

IN ACCORDANCE WITH A REQUEST FROM JOE JOHNSON - NOBLE ENERGY INC,  
STEEL SURVEYING SERVICES, LLC HAS DETERMINED THE LOCATION OF THE ABBEY D01-32D WELL  
TO BE 2039' FNL, 620' FWL, AS MEASURED AT NINETY (90) DEGREES FROM THE SECTION LINES,  
SECTION 1, TOWNSHIP 3 NORTH, RANGE 64 WEST, 6TH PRINCIPLE MERIDIAN, WELD COUNTY,  
COLORADO.

I HEREBY CERTIFY THAT THIS WELL LOCATION CERTIFICATE WAS PREPARED BY ME, OR UNDER MY DIRECT SUPERVISION, THAT THE FIELD WORK WAS COMPLETED ON 02/17/2010, FOR AND ON BEHALF OF NOBLE ENERGY INC, THAT IT IS NOT A LAND SURVEY PLAT OR AN IMPROVEMENT SURVEY PLAT, AND THAT IT IS NOT TO BE RELIED UPON FOR ESTABLISHMENT OF FENCE, BUILDING, OR OTHER FUTURE IMPROVEMENT LINES.

NOTES:

- 1) BASIS OF BEARINGS FOR THIS MAP ARE BASED UPON GPS OBSERVATIONS  
MADE ON 02/17/2010 BETWEEN MONUMENTS LOCATED AT THE SOUTHEAST  
SECTION CORNER AND THE NORTHEAST SECTION CORNER OF SAID SECTION  
AND WITH ALL BEARINGS SHOWN HEREON RELATIVE THERETO.  
2) ELEVATIONS ARE BASED UPON NGS OPUS SOLUTION NAVD 88 DATUM.  
3) THE NEAREST EXISTING WELL IS: ABBEY D1-5, 47' NORTHWEST.  
4) SEE VISIBLE IMPROVEMENTS EXHIBIT FOR ALL IMPROVEMENTS WITHIN 400'.  
5) THE LOCATION FALLS IN PASTURE LAND.

LATITUDE & LONGITUDE (NAD 83 SURFACE HOLE):

LATITUDE: N 40.25614°  
LONGITUDE: W 104.5066

PDOP: 2.1

QUARTER-QUARTER: SW/4NW/4

NEAREST PROPERTY LINE: 620' TO THE WEST

### LEGEND

- (C) CALCULATED DIMENSION

NOTICE: According to Colorado law you MUST commence any legal action based upon any defect in this W.L.C. within three years after you first discover such defect. In no event may any action based upon any defect in this W.L.C. be commenced more than ten years from this sale date of the certification shown hereon.

David C. Holmes  
Professional Land Surveyor Registration No. 32828  
State of Colorado

JOB #: 10086

Completed 03/03/2010

