


T1N, R98W, 6th P.M.

BOPCO, L.P.

WELL LOCATION, YCF 33-43-3357, LOCATED AS SHOWN IN THE NE 1/4 SE 1/4 OF SECTION 33, T1N, R98W, 6th P.M. RIO BLANCO COUNTY, COLORADO.

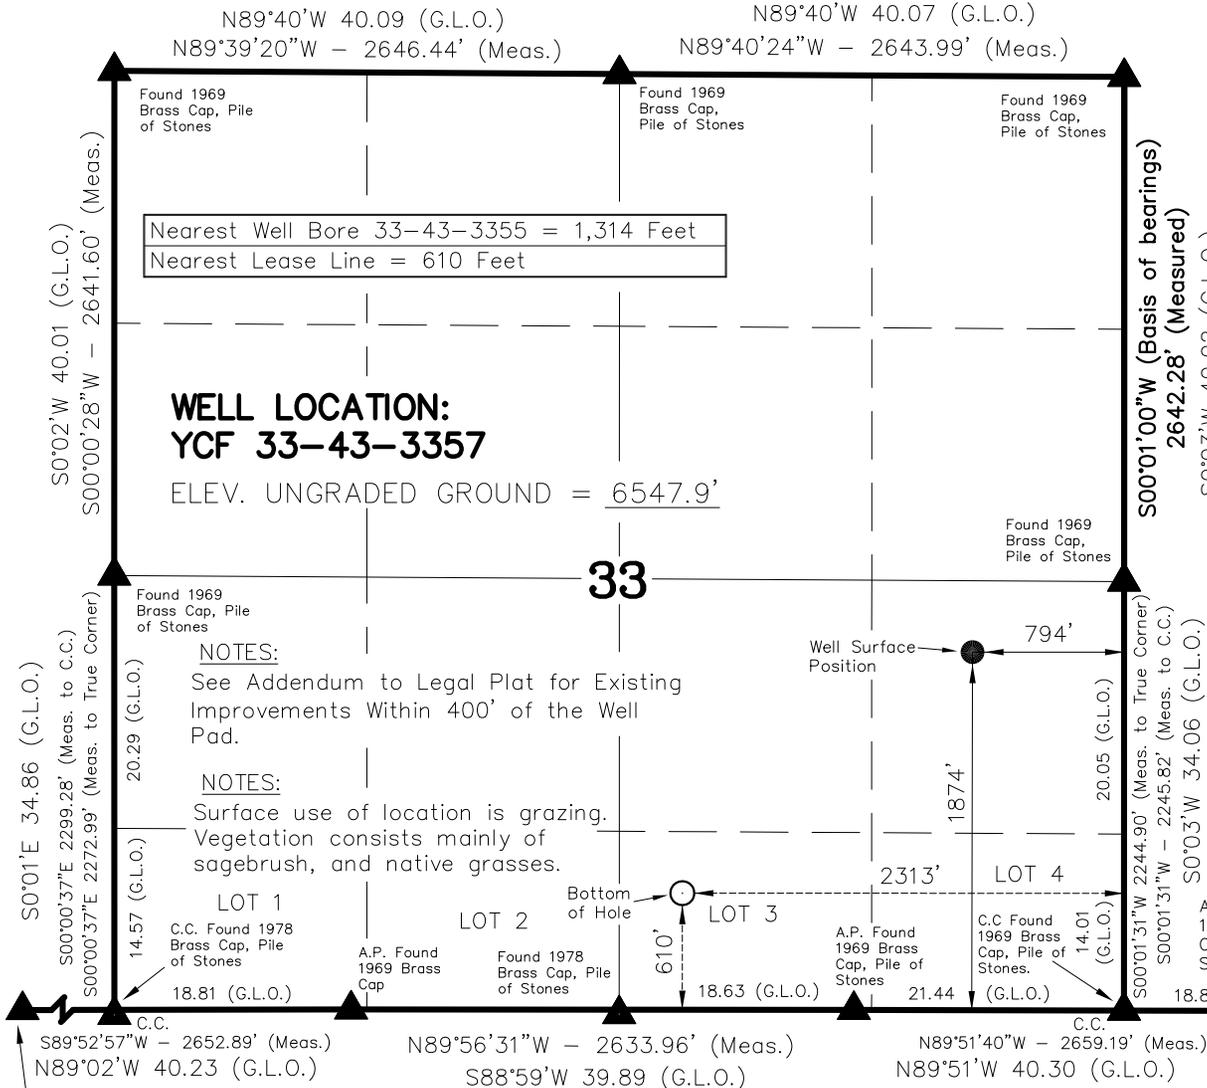


Nearest Well Bore 33-43-3355 = 1,314 Feet
Nearest Lease Line = 610 Feet

**WELL LOCATION:
YCF 33-43-3357**

ELEV. UNGRADED GROUND = 6547.9'

NOTES:
See Addendum to Legal Plat for Existing Improvements Within 400' of the Well Pad.

NOTES:
Surface use of location is grazing. Vegetation consists mainly of sagebrush, and native grasses.

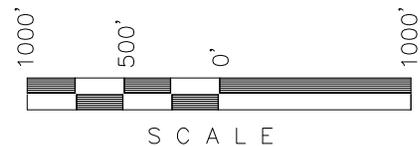

NOTES:

1. Well footages are measured at right angles to the Section Lines.
2. G.L.O. distances are shown in feet or chains. 1 chain = 66 feet.
3. Bearings are based on Global Positioning Satellite observations.
4. The Bottom of hole bears S50°18'23"W 1975.71' from the Surface Position.
5. BASIS OF ELEVATION IS A SPOT ELEVATION AT A ROAD INTERSECTION LOCATED IN THE SW 1/4 NE 1/4 OF SECTION 32, T1N, R98W, 6th P.M. THE ELEVATION OF THIS ROAD INTERSECTION IS MARKED ON THE BARCUS CREEK 7.5 MIN. QUADRANGLE AS BEING 6727'.

THIS IS TO CERTIFY THAT THE ABOVE PLAT WAS PREPARED FROM FIELD NOTES OF ACTUAL SURVEYS MADE BY ME OR UNDER MY SUPERVISION AND THAT THE SAME ARE TRUE AND CORRECT TO THE BEST OF MY KNOWLEDGE AND BELIEF.

Kathy R. Kay
REGISTERED LAND SURVEYOR
REGISTRATION No. 17982
STATE OF COLORADO

▲ = SECTION CORNERS LOCATED

YCF 33-43-3357
(Bottom Hole) NAD 83
LATITUDE = 40.00727°N
(40° 00' 26.18"N)
LONGITUDE = 108.39538°W
(108° 23' 43.35"W)

YCF 33-43-3357
(Proposed Well Head) NAD 83
LATITUDE = 40.01074°N
(40° 00' 38.65"N)
LONGITUDE = 108.38995°W
(108° 23' 23.82"W)
Operator: Brock Slaugh / PDOP = 3.1


TIMBERLINE (435) 789-1365
ENGINEERING & LAND SURVEYING, INC.
38 WEST 100 NORTH - VERNAL, UTAH 84078

DATE SURVEYED: 12-12-07	SURVEYED BY: B.J.S.	SHEET 2a OF 10
DATE DRAWN: 04-17-08	DRAWN BY: M.W.W.	
SCALE: 1" = 1000'	Date Last Revised: 04-22-10 M.W.W.	


BOPCO, L.P.

ADDENDUM TO LEGAL PLAT

YCF 33-43-1, YCF 33-43-3373, YCF 33-43-3415,
YCF 33-43-3355, YCF 33-43-3357 & YCF 33-43-3377

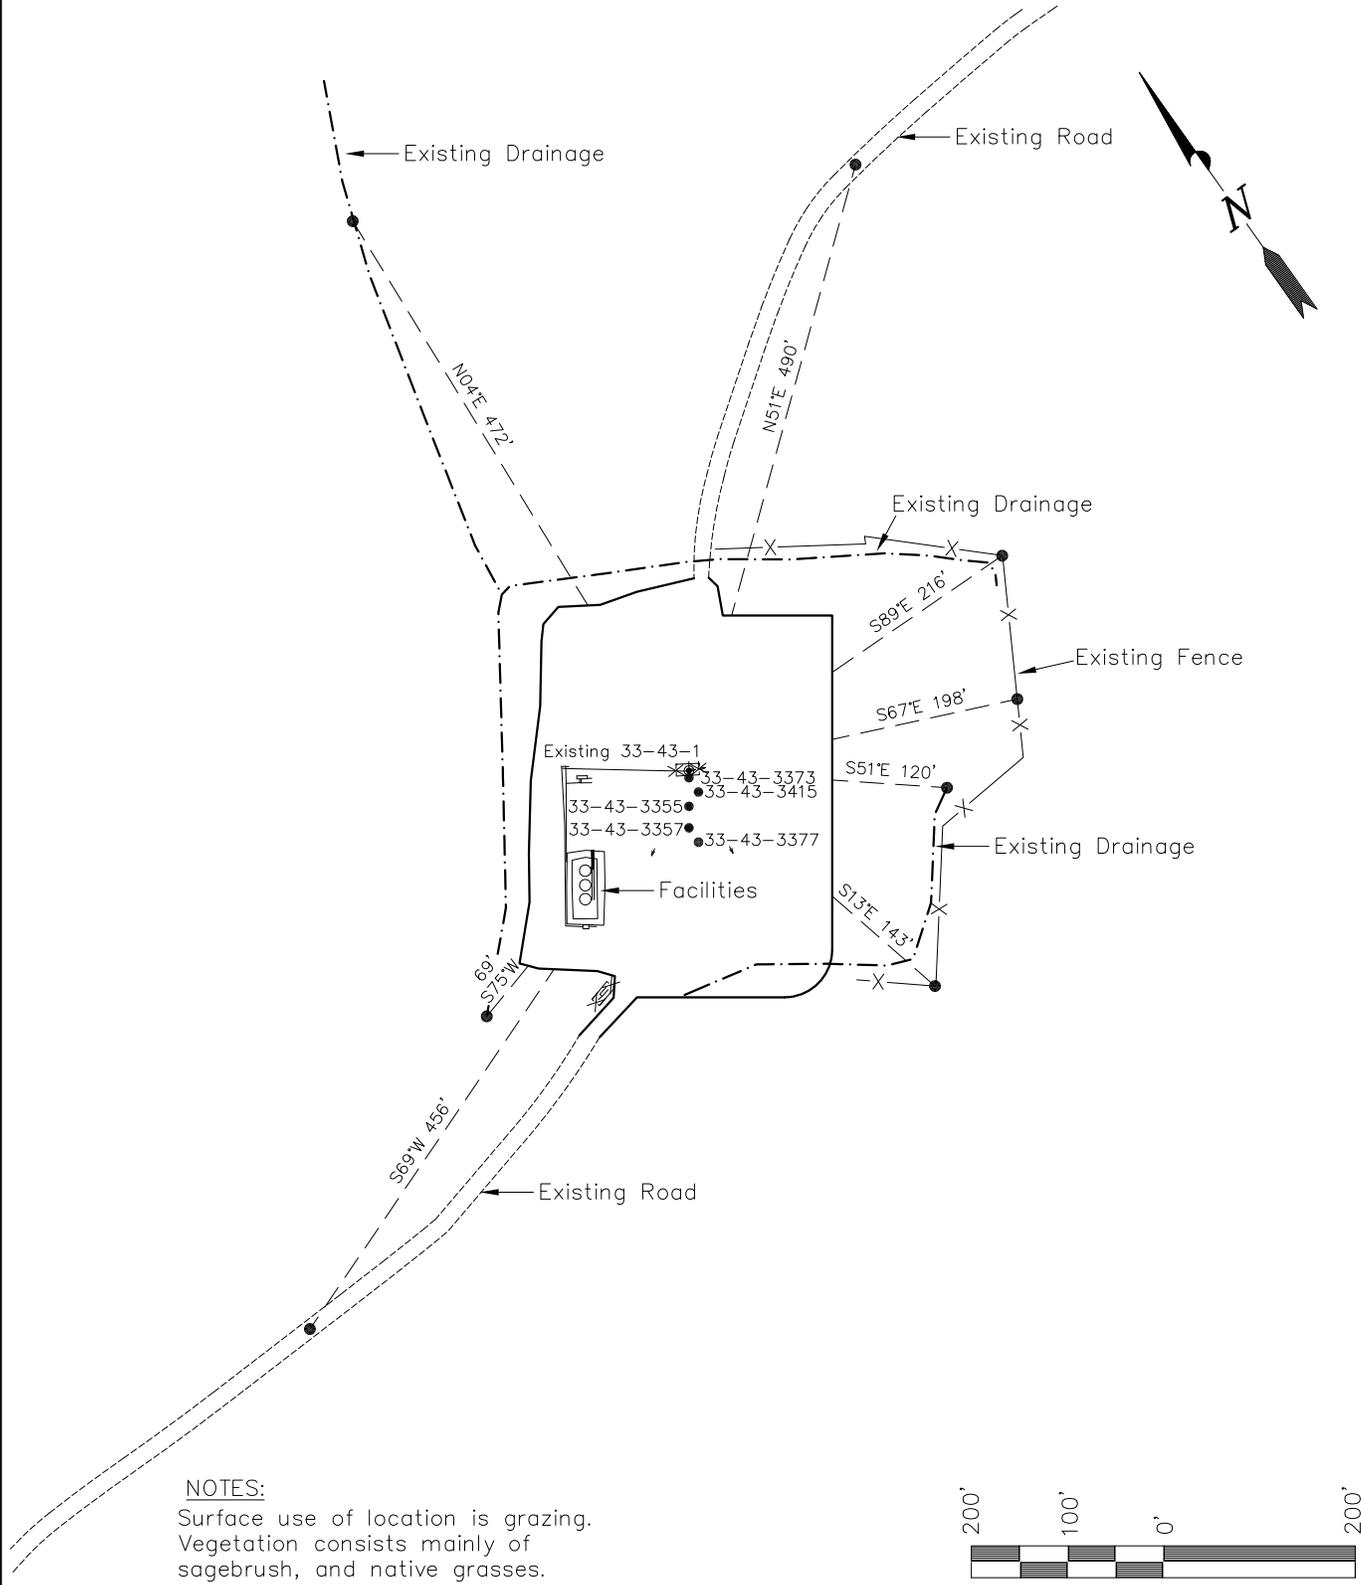

NOTES:
Surface use of location is grazing.
Vegetation consists mainly of sagebrush, and native grasses.

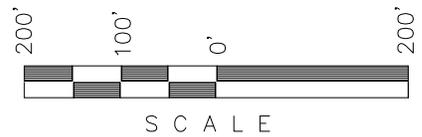

Section 33, T1N, R98W, 6th P.M.		Qtr/Qtr Location: NE SE (Surface)		Timberline (435) 789-1365 Engineering & Land Surveying, Inc. 209 NORTH 300 WEST VERNAL, UTAH 84078	SHEET 2b OF 10
Date Surveyed: 12-10-07	Date Drawn: 04-17-08	Date Last Revision: 04-22-10 M.W.W.			
Surveyed By: B.J.S.	Drawn By: M.W.W.	Scale: 1" = 200'			