


# T1N, R98W, 6th P.M.

# BOPCO, L.P.

WELL LOCATION, YCF 33-43-3355, LOCATED AS SHOWN IN THE NE 1/4 SE 1/4 OF SECTION 33, T1N, R98W, 6th P.M. RIO BLANCO COUNTY, COLORADO.

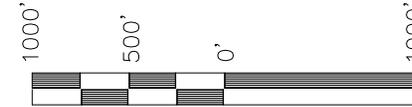


SCALE

**NOTES:**

1. Well footages are measured at right angles to the Section Lines.
2. G.L.O. distances are shown in feet or chains. 1 chain = 66 feet.
3. Bearings are based on Global Positioning Satellite observations.
4. The Bottom of hole bears N88°44'32"W 1533.15' from the Surface Position.
5. BASIS OF ELEVATION IS A SPOT ELEVATION AT A ROAD INTERSECTION LOCATED IN THE SW 1/4 NE 1/4 OF SECTION 32, T1N, R98W, 6th P.M. THE ELEVATION OF THIS ROAD INTERSECTION IS MARKED ON THE BARCUS CREEK 7.5 MIN. QUADRANGLE AS BEING 6727'.

THIS IS TO CERTIFY THAT THE ABOVE PLAT WAS PREPARED FROM FIELD NOTES OF ACTUAL SURVEYS MADE BY ME OR UNDER MY SUPERVISION AND THAT THE SAME ARE TRUE AND CORRECT TO THE BEST OF MY KNOWLEDGE AND BELIEF.

*Kelly Kay*  
 REGISTERED LAND SURVEYOR  
 REGISTRATION No. 37982  
 STATE OF COLORADO

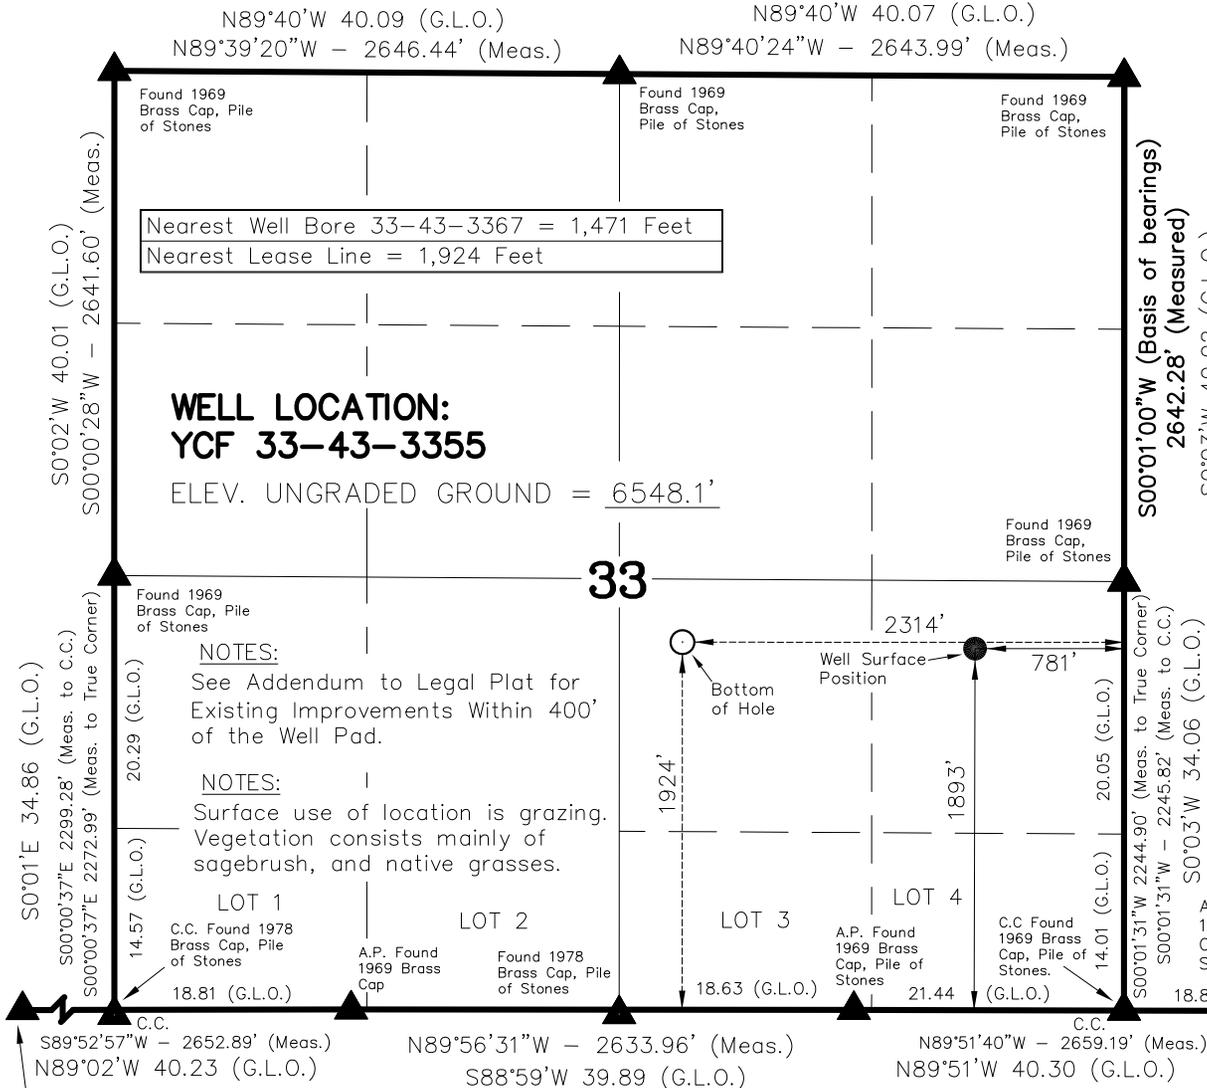

▲ = SECTION CORNERS LOCATED

**YCF 33-43-3355**  
**(Bottom Hole) NAD 83**  
 LATITUDE = 40.01088°N  
 (40° 00' 39.16"N)  
 LONGITUDE = 108.39537°W  
 (108° 23' 43.34"W)

**YCF 33-43-3355**  
**(Proposed Well Head) NAD 83**  
 LATITUDE = 40.01079°N  
 (40° 00' 38.83"N)  
 LONGITUDE = 108.38990°W  
 (108° 23' 23.65"W)  
 Operator: Brock Slaugh / PDOP = 3.0


**TIMBERLINE** (435) 789-1365  
**ENGINEERING & LAND SURVEYING, INC.**  
 38 WEST 100 NORTH - VERNAL, UTAH 84078

DATE SURVEYED: 12-12-07	SURVEYED BY: B.J.S.	<b>SHEET</b> <b>2a</b> <b>OF 10</b>
DATE DRAWN: 12-13-07	DRAWN BY: M.W.W.	
SCALE: 1" = 1000'	Date Last Revised: 04-22-10 M.W.W.	


# BOPCO, L.P.

## ADDENDUM TO LEGAL PLAT

YCF 33-43-1, YCF 33-43-3373, YCF 33-43-3415,  
YCF 33-43-3355, YCF 33-43-3357 & YCF 33-43-3377

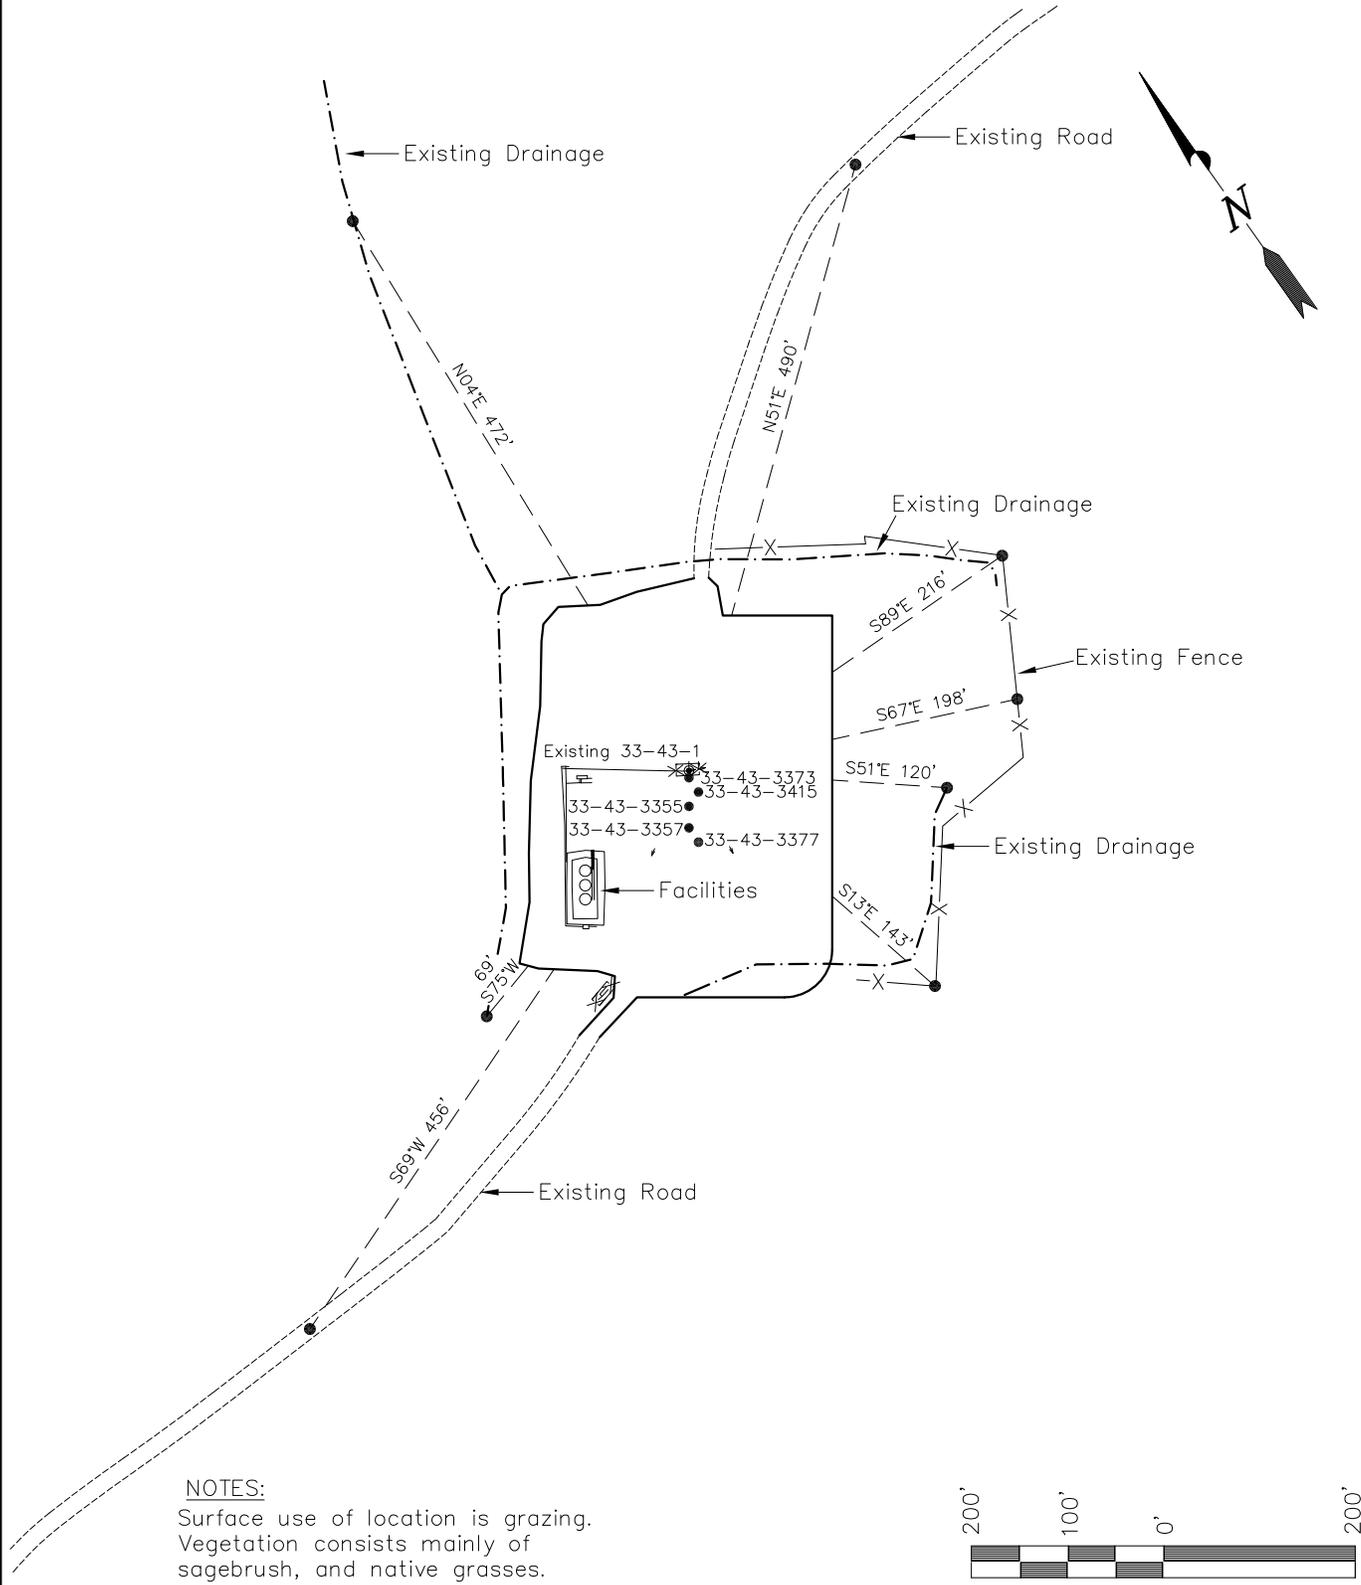

**NOTES:**  
Surface use of location is grazing.  
Vegetation consists mainly of sagebrush, and native grasses.

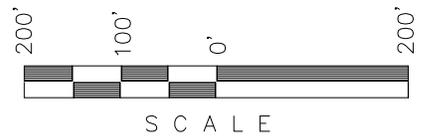

Section 33, T1N, R98W, 6th P.M.		Qtr/Qtr Location: NE SE (Surface)		<b>Timberline</b> (435) 789-1365 Engineering & Land Surveying, Inc. 209 NORTH 300 WEST VERNAL, UTAH 84078	<b>SHEET 2b OF 10</b>
Date Surveyed: 12-10-07	Date Drawn: 04-17-08	Date Last Revision: 04-22-10 M.W.W.			
Surveyed By: B.J.S.	Drawn By: M.W.W.	Scale: 1" = 200'			