

COLORADO WELL LOCATION

OPERATOR: Pioneer Natural Resources

WELL NAME: Dr Proctor 12-30 (Revised)

SECTION 30 TOWNSHIP 32 S, RANGE 65 W OF THE 6TH P.M., IN LAS ANIMAS COUNTY

ACTUAL FOOTAGE OF WELL LOCATION:

936 feet from the WEST line and 2638 feet from the NORTH line.

GROUND ELEV. (NGVD29):

7210'

BASIS OF BEARING: GPS Observations

BASIS OF ELEVATION: GPS Observations

PDP: 8.0

SURFACE USE: Timber


DATE STAKED: April 19, 2010

LAT: N 37.22922°

LONG: W 104.71881° (NAD27)

LAT: N 37.22924°

LONG: W 104.71936° (NAD83)

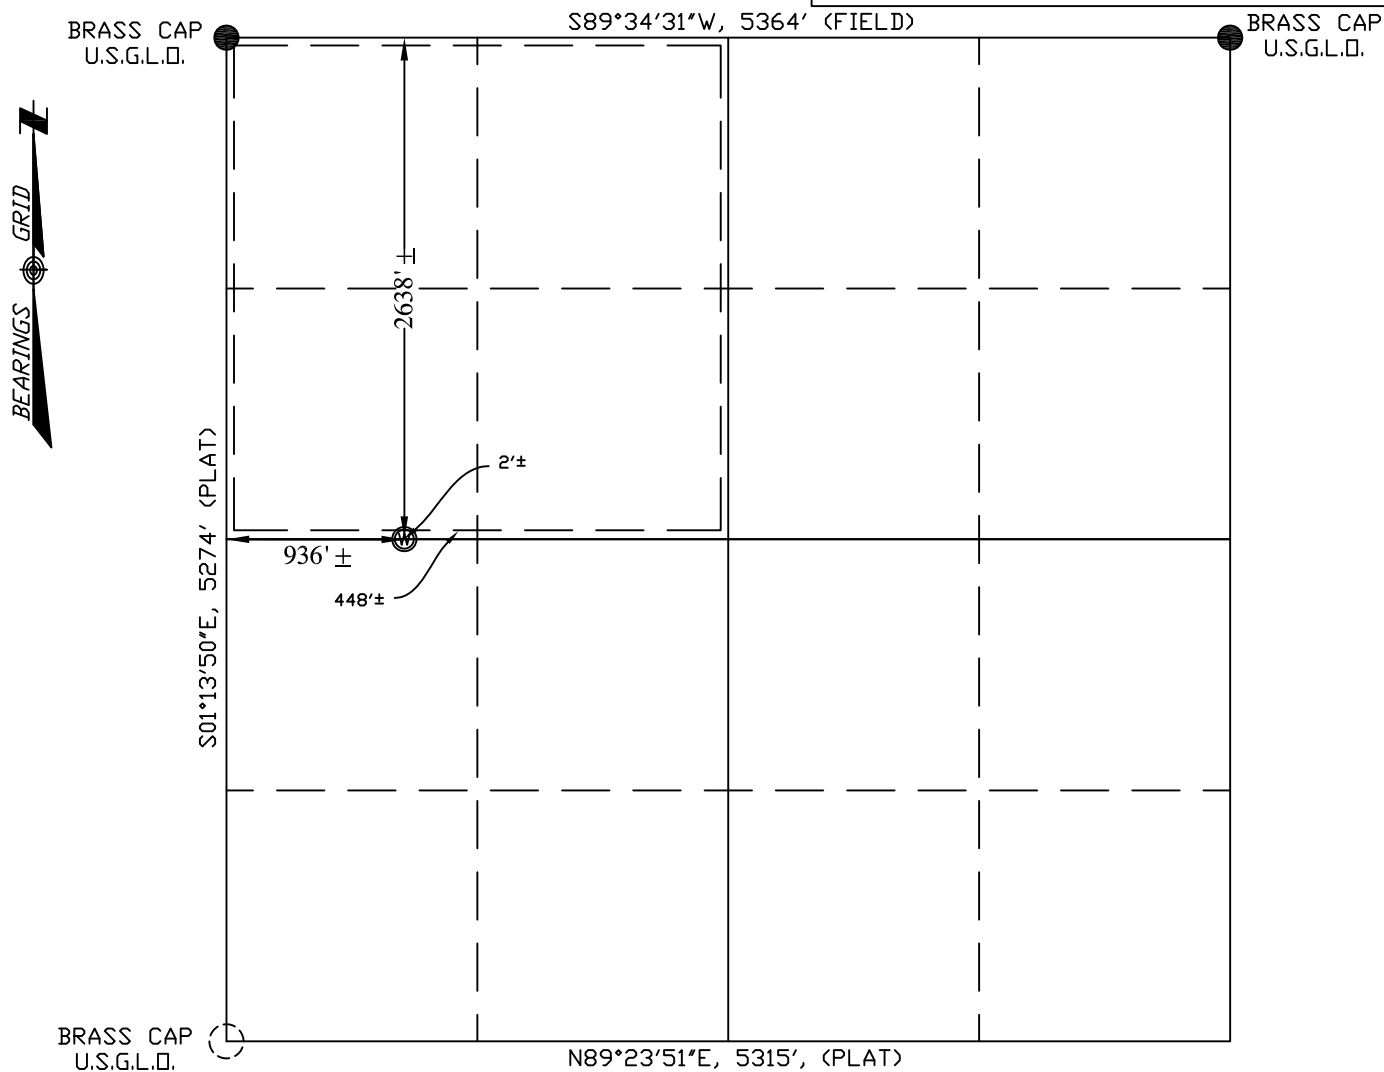





250 0 250 500 1000

(in feet)

1 inch = 1000 ft.

LEGEND:

-  = WELL LOCATION
 = SURVEY MARKER (SEE DRAWING)
 = CALCULATED POINT
 = LOCATION FURNISHED BY P.N.R.C.

Field Operator: N. Segotta

NOTICE:

SOME INFORMATION SHOWN HEREON IS BASED ON INFORMATION TAKEN FROM RECORD INFORMATION, PREVIOUS SURVEYS, PLATS AND SURVEYS BY OTHER SURVEYORS, OR COLLATERAL EVIDENCE AND MAY NOT REFLECT THAT WHICH MAY BE DISCLOSED BY A COMPLETE BOUNDARY SURVEY. **THIS SKETCH IS NOT TO BE RELIED UPON FOR THE ESTABLISHMENT OF SURFACE BOUNDARIES, FENCES, BUILDINGS OR OTHER FUTURE IMPROVEMENTS.**

I hereby certify that this proposed well location shown was plotted from field notes of a actual GIS survey and meets the requirements of Colorado Statue 38-51-109.3 and was made by me or under my supervision, and that the same is true and correct to the best of my knowledge and belief
and IS NOT A LAND SURVEY PLAT.

NOTE:

ALL WELL LOCATIONS AND ELEVATIONS DERIVED FROM OBSERVED GPS DATA AND DIFFERENTIALLY CORRECTED TO CORS STATION PUEBLO 1 (PID #AJ6946) AND MEET AND/OR EXCEED COGCC RULE 303c AND RULE 215a-h.

NO VISIBLE IMPROVEMENTS WITHIN 200 FEET OF PROPOSED WELLHEAD UNLESS NOTED OTHERWISE.

DISTANCES ARE MEASURED AT 90° (NINETY DEGREES) FROM SAID SECTION LINES TO THE WELL LOCATION.

DESIRED PDOP MAY NOT BE OBTAINED DUE TO NATIVE CONDITIONS OF SITE.

SHIELDS SURVEY L^{td.} C^{o.} *Raton, New Mexico 87740*
(575)445-1232 9038

Norman Scott Weese

May 17, 2010

Norman Scott Weese, CO PLS #38116

Date Platted