


# ACCESS ROAD MAP

SECTION 1  
TOWNSHIP 10 NORTH  
RANGE 62 WEST

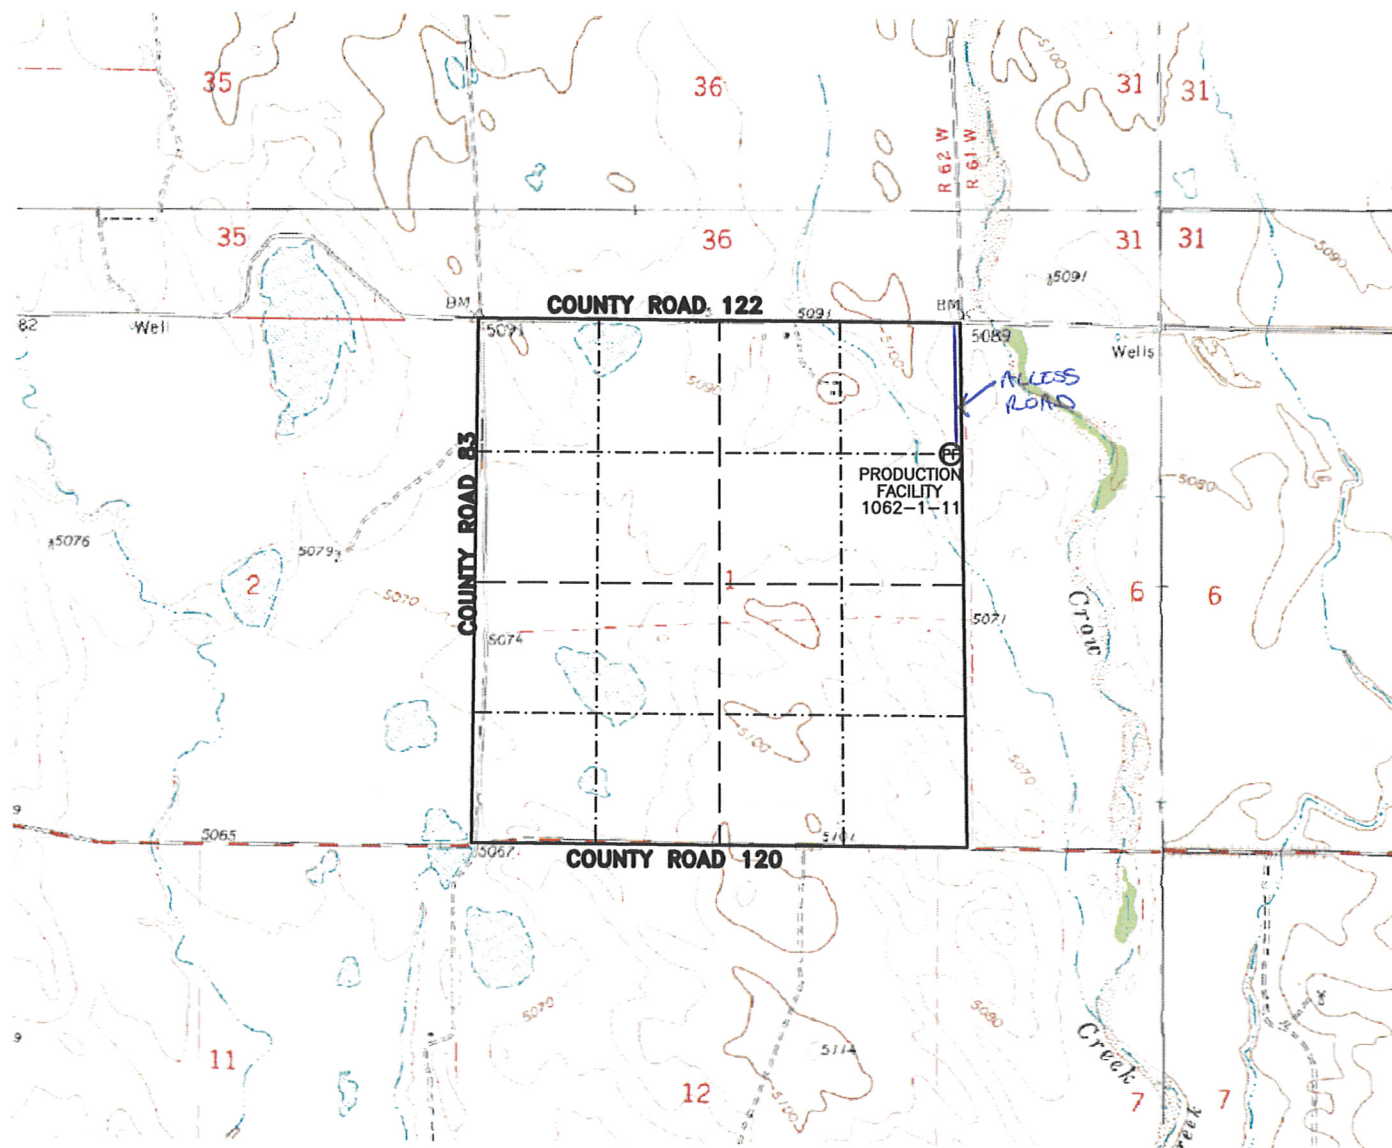

SCALE: 1"=2000'  
0 1000 2000



SCALE IN FEET