



IMPROVEMENTS

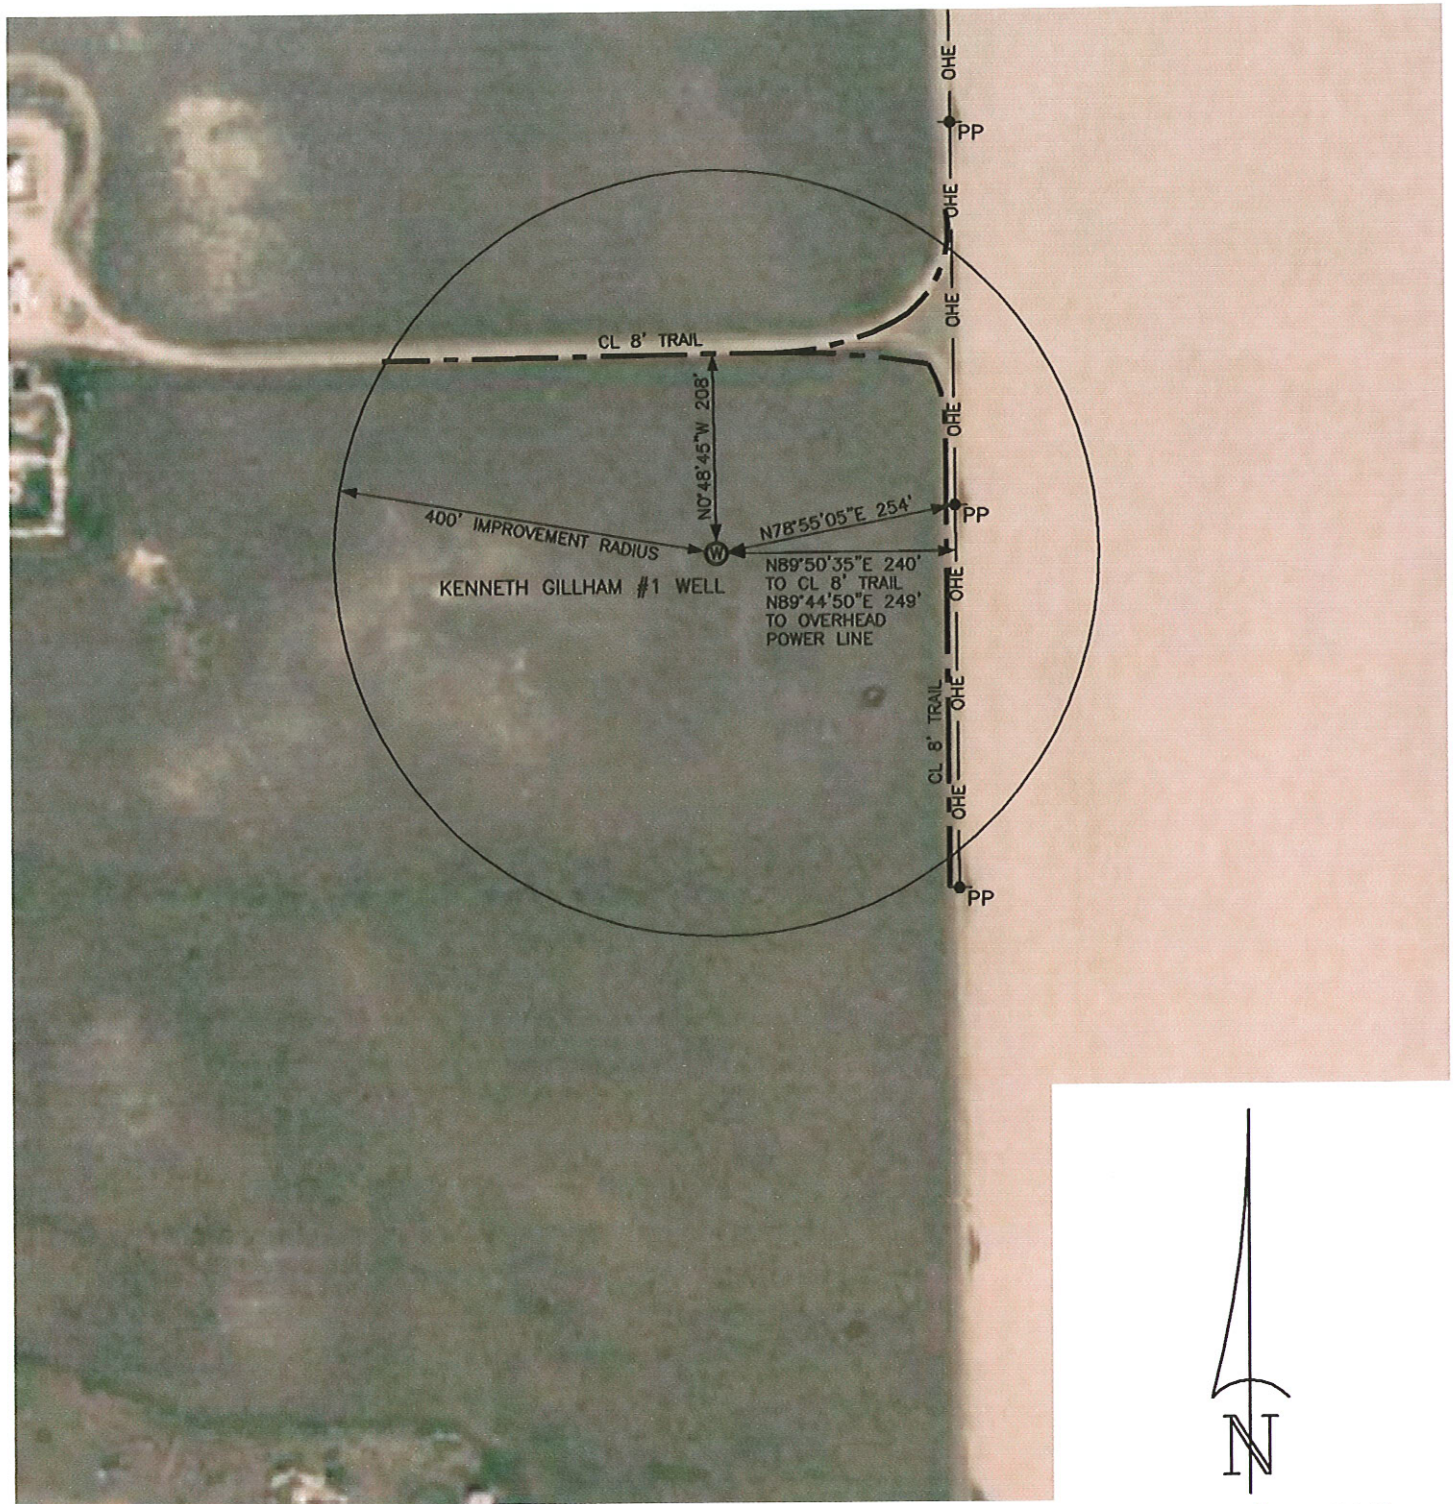

LEGEND

- Ⓢ FIELD SURVEYED WELL LOCATION
- _{PP} POWER POLE
- OHE — OVERHEAD POWER LINE

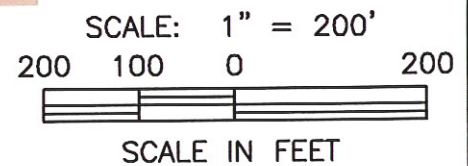

LEIBERT-McATEE & ASSOCIATES, INC.

P.O. BOX 442 615 SOUTH TENTH AVENUE
STERLING, CO 80751 970-522-1960

FIELD DATE: 1-15-10	DWG DATE: 1-22-10	GPS OPERATOR: TIM LEIBERT
KENNETH GILLHAM #1	DWG NO. 1513-09A	SHEET 2 OF 2