

Location Drawing

Steil Surveying Services, LLC


1102 West 19th Street P.O. BOX 2073

Cheyenne, Wyoming 82009

VISIBLE IMPROVEMENTS

THIS MAP DOES NOT REPRESENT A BOUNDARY SURVEY

SECTION 34
TOWNSHIP 4 NORTH
RANGE 64 WEST

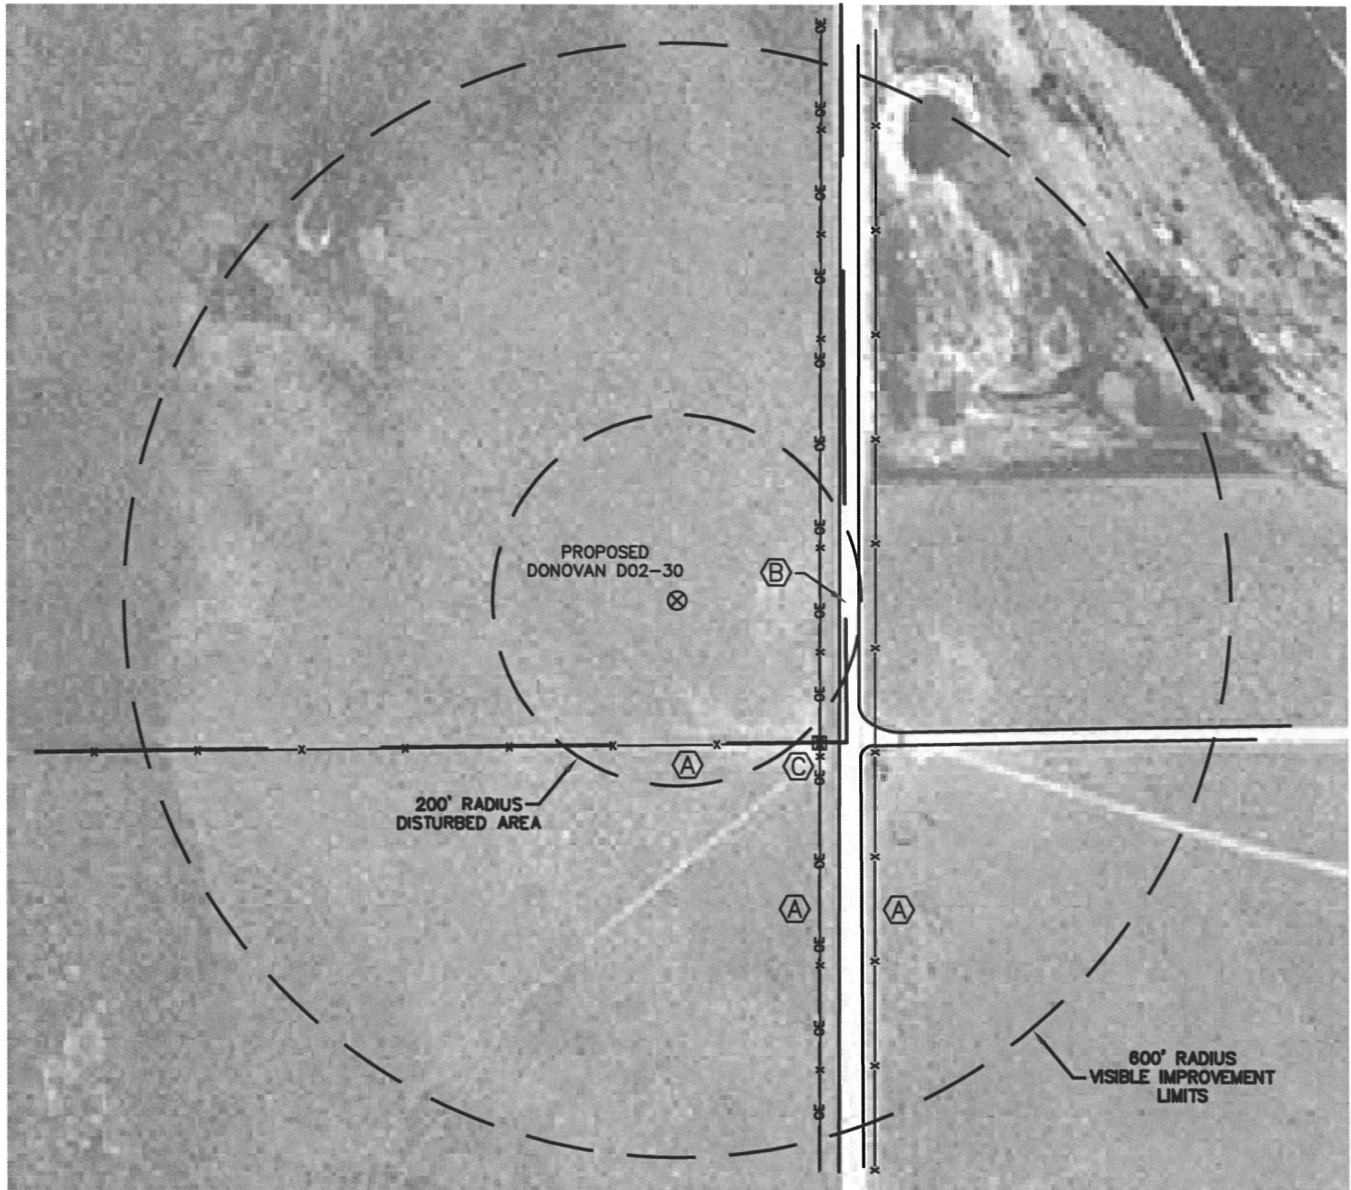

IMPROVEMENTS:

- (A) BARBED WIRE FENCES - 156' SOUTH AND 156' & 216' EAST
- (B) GRAVEL COUNTY ROAD NO. 57 - 185' EAST
- (C) BURIED GAS LINE MARKER - 218' SOUTHEAST

THE NEAREST OVERHEAD POWER LINE IS 155' EAST

NOTICE: According to Colorado law you MUST commence any legal action based upon any defect in this W.L.C. within three years after you first discover such defect. In no event may any action based upon any defect in this W.L.C. be commenced more than ten years from this sold date of the certification shown hereon.

