Contract Surveyors, Ltd. of Denver, Colorado has in accordance with a request from Steven Wolfe for Bonanza Creek Energy Operating Company, LLC, determined the location of ANTELOPE 44-18 to be 660.0' FSL & 660.3' FEL Section 18, Township 5 North, Range 62 West of the 6th Principal Meridian, Weld County, State of Colorado. The surface elevation at this point is 4636.0 feet above m.s.l. Improvements within 400 feet of the location include: The location falls within the arc of a center pivot irrigation system, not currently active.

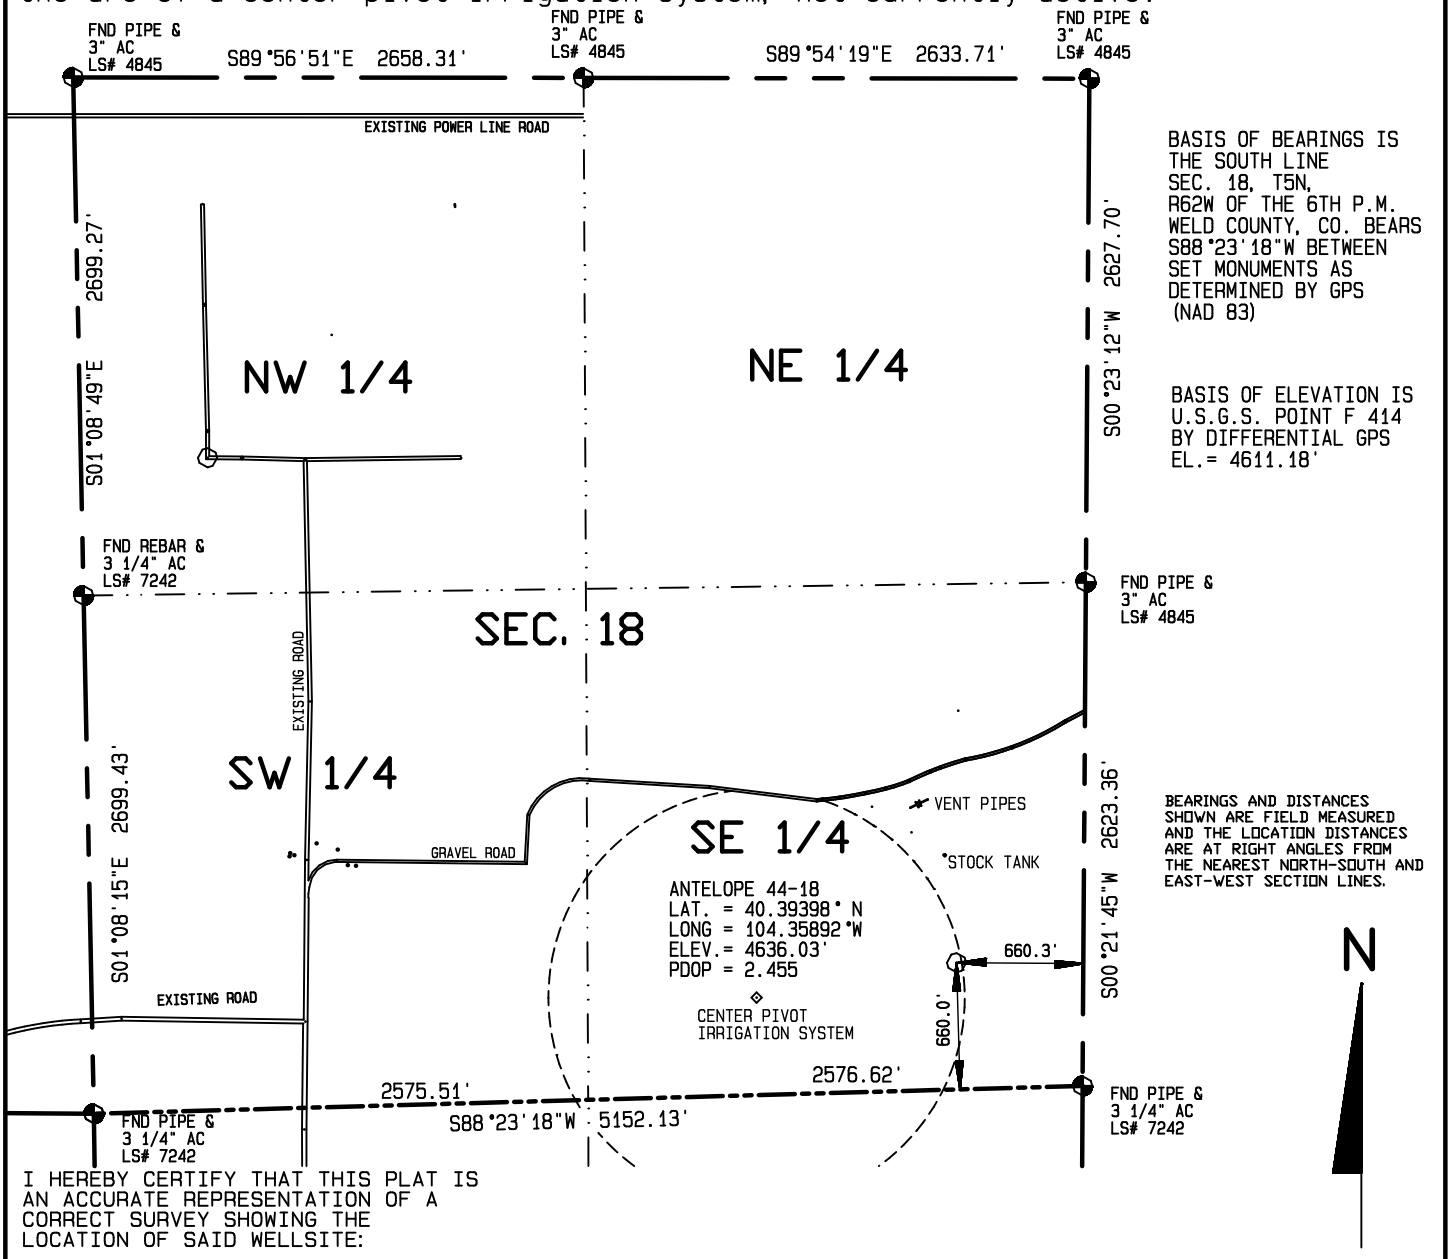


BASIS OF BEARINGS IS THE SOUTH LINE SEC. 18, T5N, R62W OF THE 6TH P.M. WELD COUNTY, CO. BEARS S88°23'18"W BETWEEN SET MONUMENTS AS DETERMINED BY GPS (NAD 83)

BASIS OF ELEVATION IS U.S.G.S. POINT F 414 BY DIFFERENTIAL GPS EL.= 4611.18'

BEARINGS AND DISTANCES SHOWN ARE FIELD MEASURED AND THE LOCATION DISTANCES ARE AT RIGHT ANGLES FROM THE NEAREST NORTH-SOUTH AND EAST-WEST SECTION LINES.

I HEREBY CERTIFY THAT THIS PLAT IS AN ACCURATE REPRESENTATION OF A CORRECT SURVEY SHOWING THE LOCATION OF SAID WELLSITE:

1000 500 0 1000

Scale 1" = 1000'

Dan Griggs PLS# 38018


**CONTRACT SURVEYORS, LTD.**
COMPLETE SURVEYING AND GLOBAL POSITIONING

2133 SOUTH BELLAIRE STREET #14
DENVER COLORADO 80222
(303) 756-3695


CSL# 10104-22

| DATE OF FIELD WORK: | DATE OF DRAWING: |
|---|---|
| 18 MAY. 2010 | 20 MAY. 2010 |

ANTELOPE 44-18

SE 1/4, SE 1/4 SEC. 18, T5N, R62W

BONANAZA CREEK ENERGY OPERATING COMPANY, LLC

WELD COUNTY, COLORADO