


DALEY LAND SURVEYING, INC.

PARKER, CO. 80134

303 953 9841

VISIBLE IMPROVEMENTS SKETCH MARLEY C01-17

SECTION 1, TOWNSHIP 4 NORTH, RANGE 64 WEST OF THE 6TH PRINCIPAL MERIDIAN

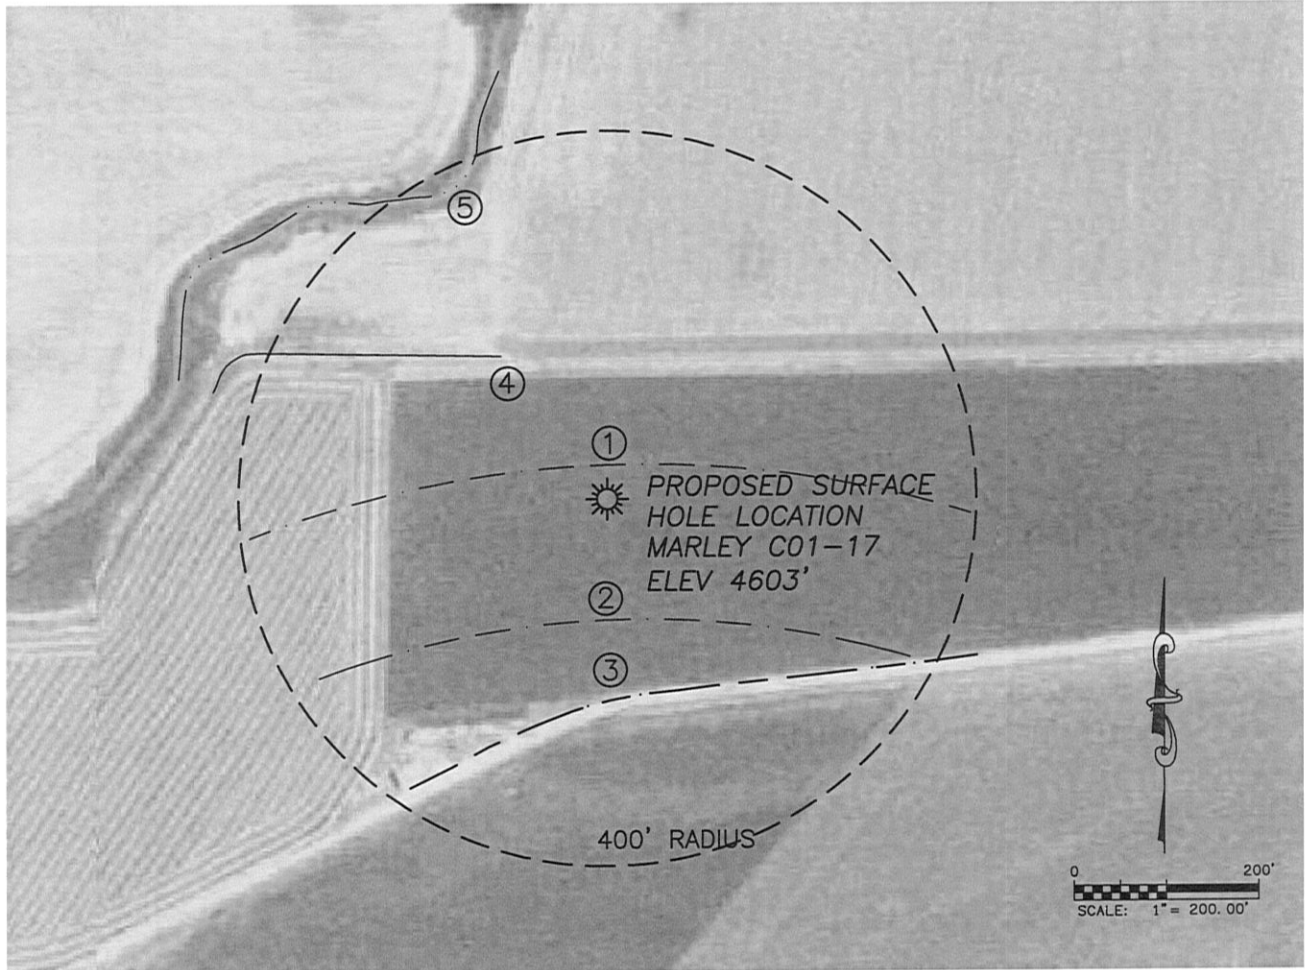

①
PIVOT TRACK
36' N

②
PIVOT TRACK
132' S

③
CENTERLINE
FIELD ROAD
219' S

④
IRRIG. DITCH
194' NW

⑤
CREEK
377' NW