WELL LOCATION CERTIFICATE

SECTION 22, TOWNSHIP 5 NORTH, RANGE 64 WEST, 6TH P.M.

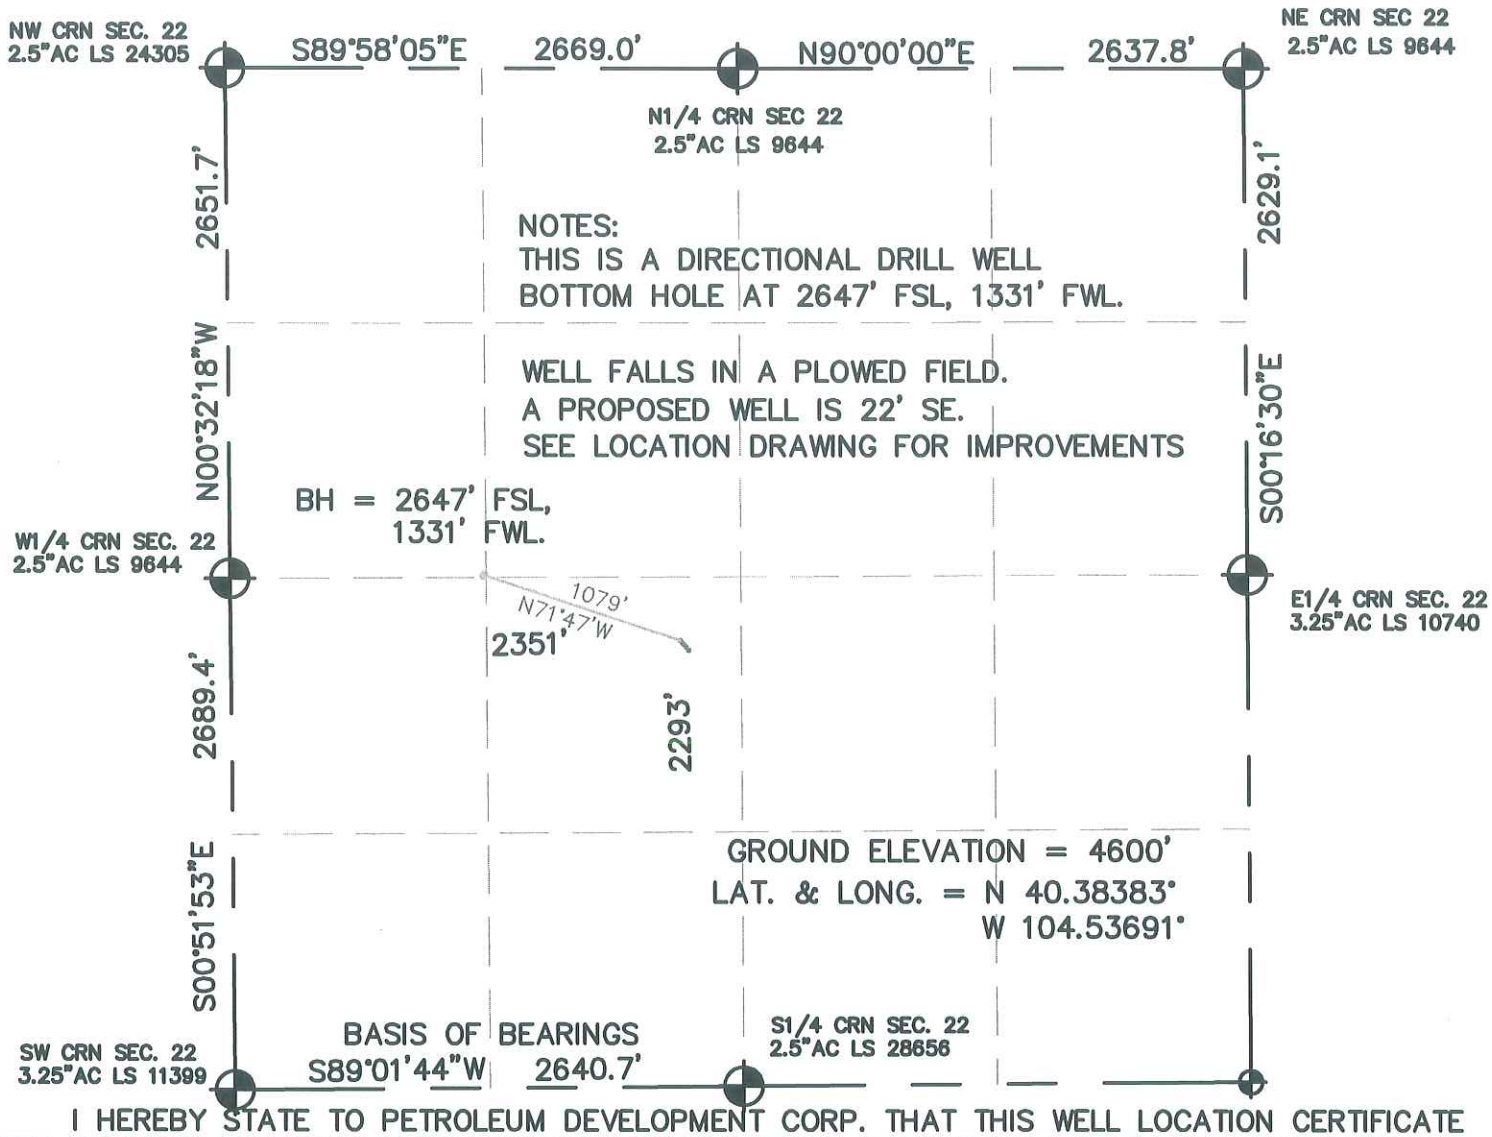

I HEREBY STATE TO PETROLEUM DEVELOPMENT CORP. THAT THIS WELL LOCATION CERTIFICATE FOR THE WELL CHESNUT 22KD IS LOCATED 2293' FSL & 2351' FWL, SEC. 22, T5N, R64W, 6PM.

24657
4-12-10

LEGEND

= FOUND MONUMENT

. = PROPOSED WELL

NORTH

0 500 1000

SCALE 1" = 1000'

ELEVATION SOURCE = USGS 7.5' QUAD.MAP CONTOURS NGVD 1929 DATUM.

LAT. & LONG. ARE DIFFERENTIALLY CORRECTED (NAD'83) USING (DGPS) WITH (PDOP) VALUES LESS THAN SIX (6).

SHOWN DISTANCES ARE FIELD MEASURED – EXTERIOR SECTION LINES ARE DRAWN TO SCALE (BEST APPROX. OR FOUND MONUMENT ✦).

DISTANCES TO WELL SHOWN PERPENDICULAR TO SECTION LINES.

THOMAS G. CARLSON, PLS 24657
HORSESHOE SURVEYING, LLC

THIS IS NOT A MONUMENTED BOUNDARY SURVEY, IT IS ONLY A DRAWING INTENDED TO DEPICT THE WELL LOCATION TO SECTION LINES.

PREPARED BY:	HORSESHOE SURVEYING, LLC PO BOX 150458 LAKEWOOD, CO 80215 (720)872-0196	WELL NAME:	CHESNUT 22KD
DRAWING DATE: 4-12-10		LOCATION:	WELD COUNTY, CO SW1/4, SEC. 22, T5N, R64W, 6TH P.M.
FIELD DATE: 4-8-10	BY: TGC / CHKD:	JOB NO.	SHEET NO. 1 OF 1