

True Oil Company

Well location, Breeze Unit 23-15, located as shown in Lot 11 of Section 15, T6N, R89W, 6th P.M., Routt County, Colorado.


Basis of Elevation

Elevations are based on Static GPS observations, post processed. Elevation = 6600 NGVD 29.

Basis of Bearing

Bearings are based on Static GPS observations of existing HARN points and post processed to provide NAD83 coordinates.

NAD 83
 Latitude = N40°28'23.74105" (N40.473261 Degrees)
 Longitude = W107°21'48.51706 (W107.363477 Degrees)

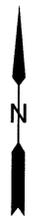


Scale 1" = 1000 U.S. feet

Surveyor's Statement

I, Peter Epp, a duly registered Professional Land Surveyor in the State of Colorado do hereby certify that the survey represented by this drawing was done by me or under my direct supervision and is in accordance with the applicable standards of practice and is accurate based upon my best knowledge, information and belief and correctly shows the location of Breeze Unit 23-15.

Peter Epp, Colorado, L.S. No. 13845
 Date: this 27th day of June, 2010.
 Observations of 1.8. Observations are in compliance with COGCC Rule No. 215.

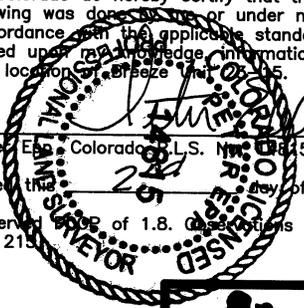

Explanation

- Denotes found GLO brass cap monument set in 1910
- Denotes 90° symbol
- Well Location

High Desert Plateau. No visible improvements within 200 foot radius of well site except as shown. Surface use is native pasture.

The word "certify" or "certification" as used herein is understood to be an expression of professional opinion by the surveyor, based upon his best knowledge, information, and belief. As such, it does not constitute a guarantee, nor a warranty, expressed or implied.



EPP & ASSOCIATES, INC.
 PROFESSIONAL LAND SURVEYORS

433 4th Avenue West
 P.O. Box 837
 Craig, CO 81625

Phone (970) 824-8236
 Fax (970) 824-5227

True Oil Company
Breeze Unit 23-15

Scale 1" = 1000'	Date 03apr10	Drawing No.	Job No. 10.109-01
Drawn By P. Epp			