


CONSTRUCTION LAYOUT DRAWING

1 of 3


PAD CONSTRUCTED
PAD ELEV=6794.2

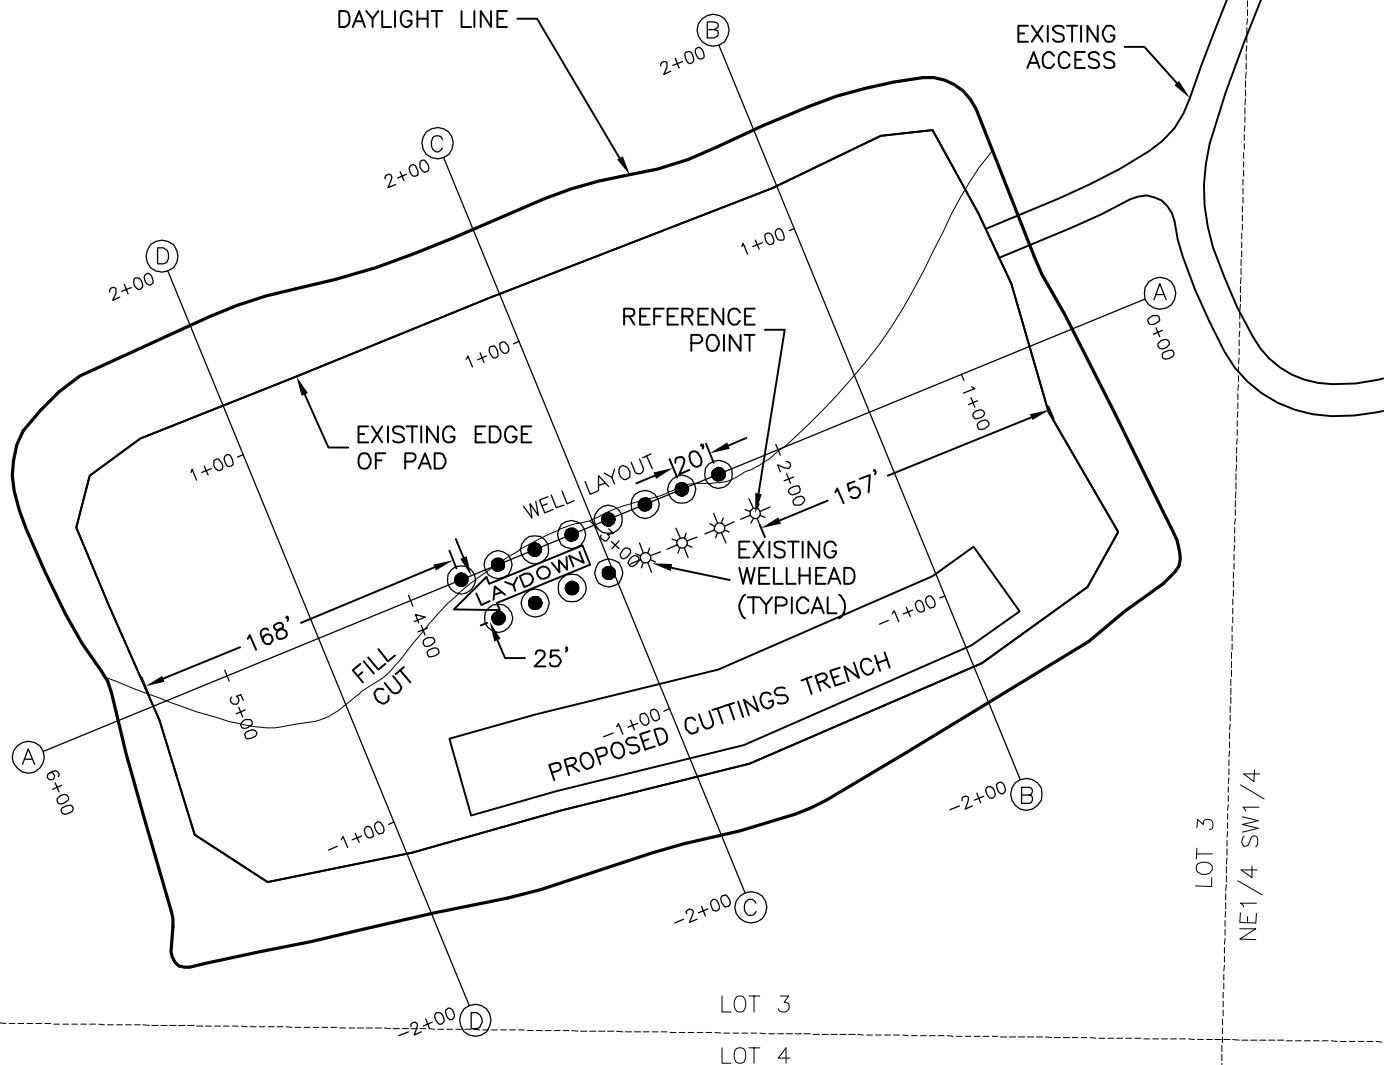

WELL LAYOUT

31-13D	31-13C
31-14C	31-13A
31-14B	31-12D
31-14A	31-12C
31-13B	31-12A
31-12B	31-11A
31-14D	31-11C
31-11D	31-11B


12/15/09

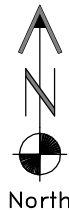

North

NOTES:

- 1) 10% ALLOWANCE IS MADE FOR SOIL EXPANSION.
- 2) CUTTINGS TRENCH LOCATION & SIZE TO BE DETERMINED AT TIME OF CONSTRUCTION.

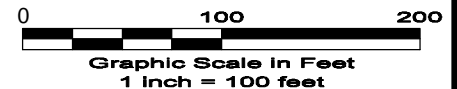

GEO SURV



LAND SURVEYING AND MAPPING
LAFAYETTE - WINTER PARK
Ph 303 666 0379 Fx 303 665 6320

**LARAMIE ENERGY II LLC
LEVERICH 31-12 PAD**

**GOVT LOT 3 SEC. 31 T6S R93W
6th PM GARFIELD COUNTY COLORADO**

CONSTRUCTION LAYOUT DRAWING

2 of 3

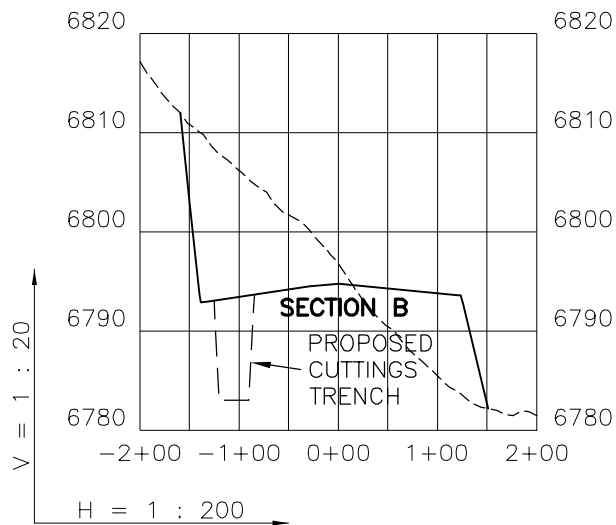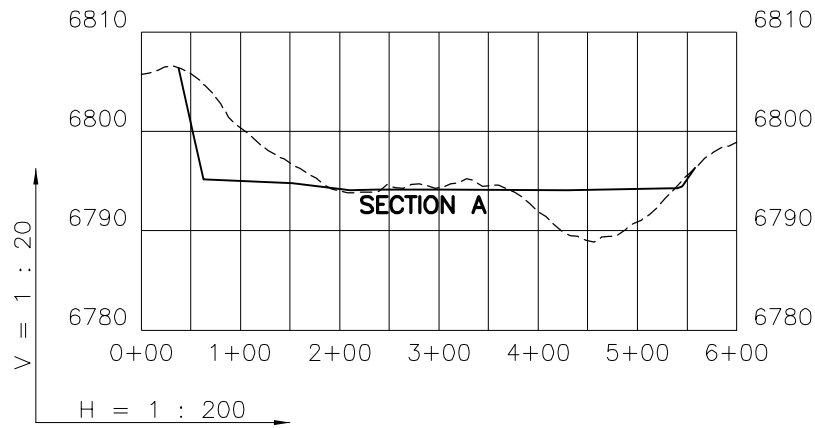

12/15/09

----- Pre-Construction

————— As-built Grade

GEO SURV



LAND SURVEYING AND MAPPING
LAFAYETTE - WINTER PARK
Ph 303 666 0379 Fx 303 665 6320

LARAMIE ENERGY II LLC
LEVERICH 31-12 PAD

GOVT LOT 3 SEC. 31 T6S R93W
6th PM GARFIELD COUNTY COLORADO

CONSTRUCTION LAYOUT DRAWING

3 of 3

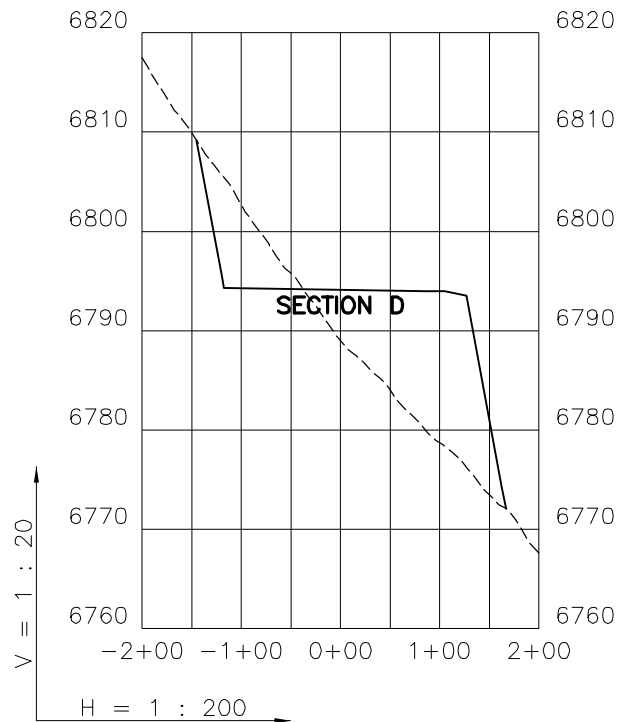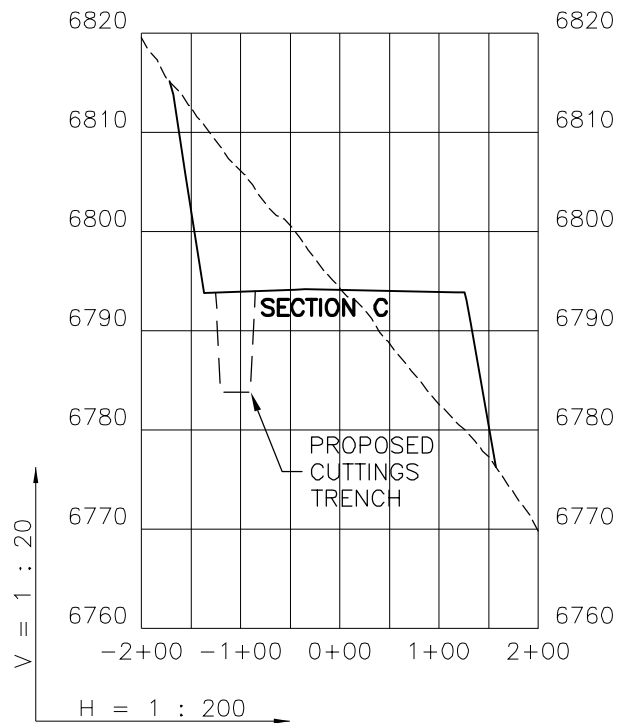

12/15/09

----- Pre-Construction

————— As-built Grade

GEO SURV

LAND SURVEYING AND MAPPING
LAFAYETTE - WINTER PARK
Ph 303 666 0379 Fx 303 665 6320

**LARAMIE ENERGY II LLC
LEVERICH 31-12 PAD**

**GOVT LOT 3 SEC. 31 T6S R93W
6th PM GARFIELD COUNTY COLORADO**