

T7S, R92W, 6th P.M.

ENCANA OIL & GAS (USA) INC

WELL LOCATION, ENCANA-FEE 10-2D (A10E), LOCATED AS SHOWN IN THE NE 1/4 NE 1/4 OF SECTION 10, T7S, R92W, 6th P.M. GARFIELD COUNTY, COLORADO.


Set Stone WEST - (G.L.O.) 2001 Alum. Cap LS 31143
S89°19'20"W - 2646.60' (Meas.)

WEST (G.L.O.) Set Stone
S88°59'39"W - 2640.54' (Meas.)

Sec. 3

Sec. 2

WELL LOCATION:
ENCANA-FEE 10-2D (A10E)
ELEV. UNGRADED GROUND = 6046.2'

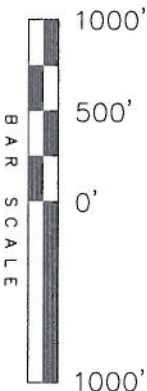

NOTES:

1. Well footages are measured at right angles to the Section Lines.
2. Bearings are based on Global Positioning Satellite observations.
3. The top of hole footages are 436' FWL & 22' FEL.
4. G.P.S. Operator: C.D. Slaugh, (PDOP) = 3.5

THIS IS TO CERTIFY THAT THE ABOVE PLAT WAS PREPARED FROM FIELD NOTES, AND SURVEYS MADE BY ME OR UNDER MY SUPERVISION AND THAT THE SAME ARE TRUE AND CORRECT TO THE BEST OF MY KNOWLEDGE AND BELIEF.

REGISTERED LAND SURVEYOR
REGISTRATION No. 30125
STATE OF COLORADO
LAND SURVEYOR

Sec. 10

Sec. 11

SECTION CORNERS LOCATED

South East Corner
Section 10
(3/4" Rebar at Set Stone)

NAD 83 (SURFACE LOCATION)
LATITUDE = 39°28'03.35"
(39.467597)
LONGITUDE = 107°38'35.42"
(107.643172)

Basis of elevation is the Rifle 2 Triangulation Station. 39°31'53.80" N Lat. & 107°47'07.78" W Long. (NAD 83). Elevation = 5323.1' (NAVD88).

TRI STATE LAND SURVEYING & CONSULTING
180 NORTH VERNAL AVE. - VERNAL, UTAH 84078
(435) 781-2501

DATE SURVEYED: 10-20-06
DATE DRAWN: 11-1-06
REVISION: 02-01-10 F.T.M.
SURVEYED BY: C.D.S.
DRAWN BY: R.V.C.
SCALE: 1" = 1000'

SHEET
2C