


PLAT #1  
LOCATION PLAT

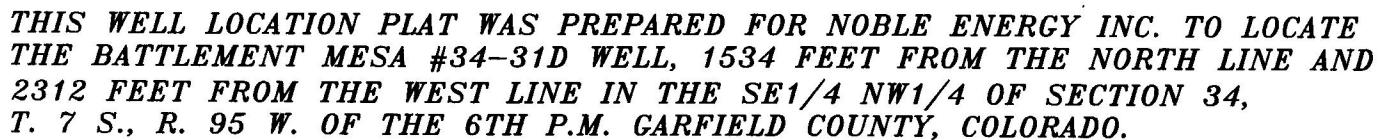

## SURVEYOR'S CERTIFICATE

- I, George R. Bauer: a Professional Land Surveyor in the State of Colorado do hereby certify that this Survey was made under my direct supervision, that this Plot represents said Survey and the location has been staked as shown hereon.



VIEW: 1J

SURVEYED: 01/10/08	SCALE: 1" = 1000'
DRAFTED: 06/05/09	DWG: NOBLE\2006\BM 34F
REVISED: 06/08/09	SHEET: 1 of 9