


# TIMM 943-19-23

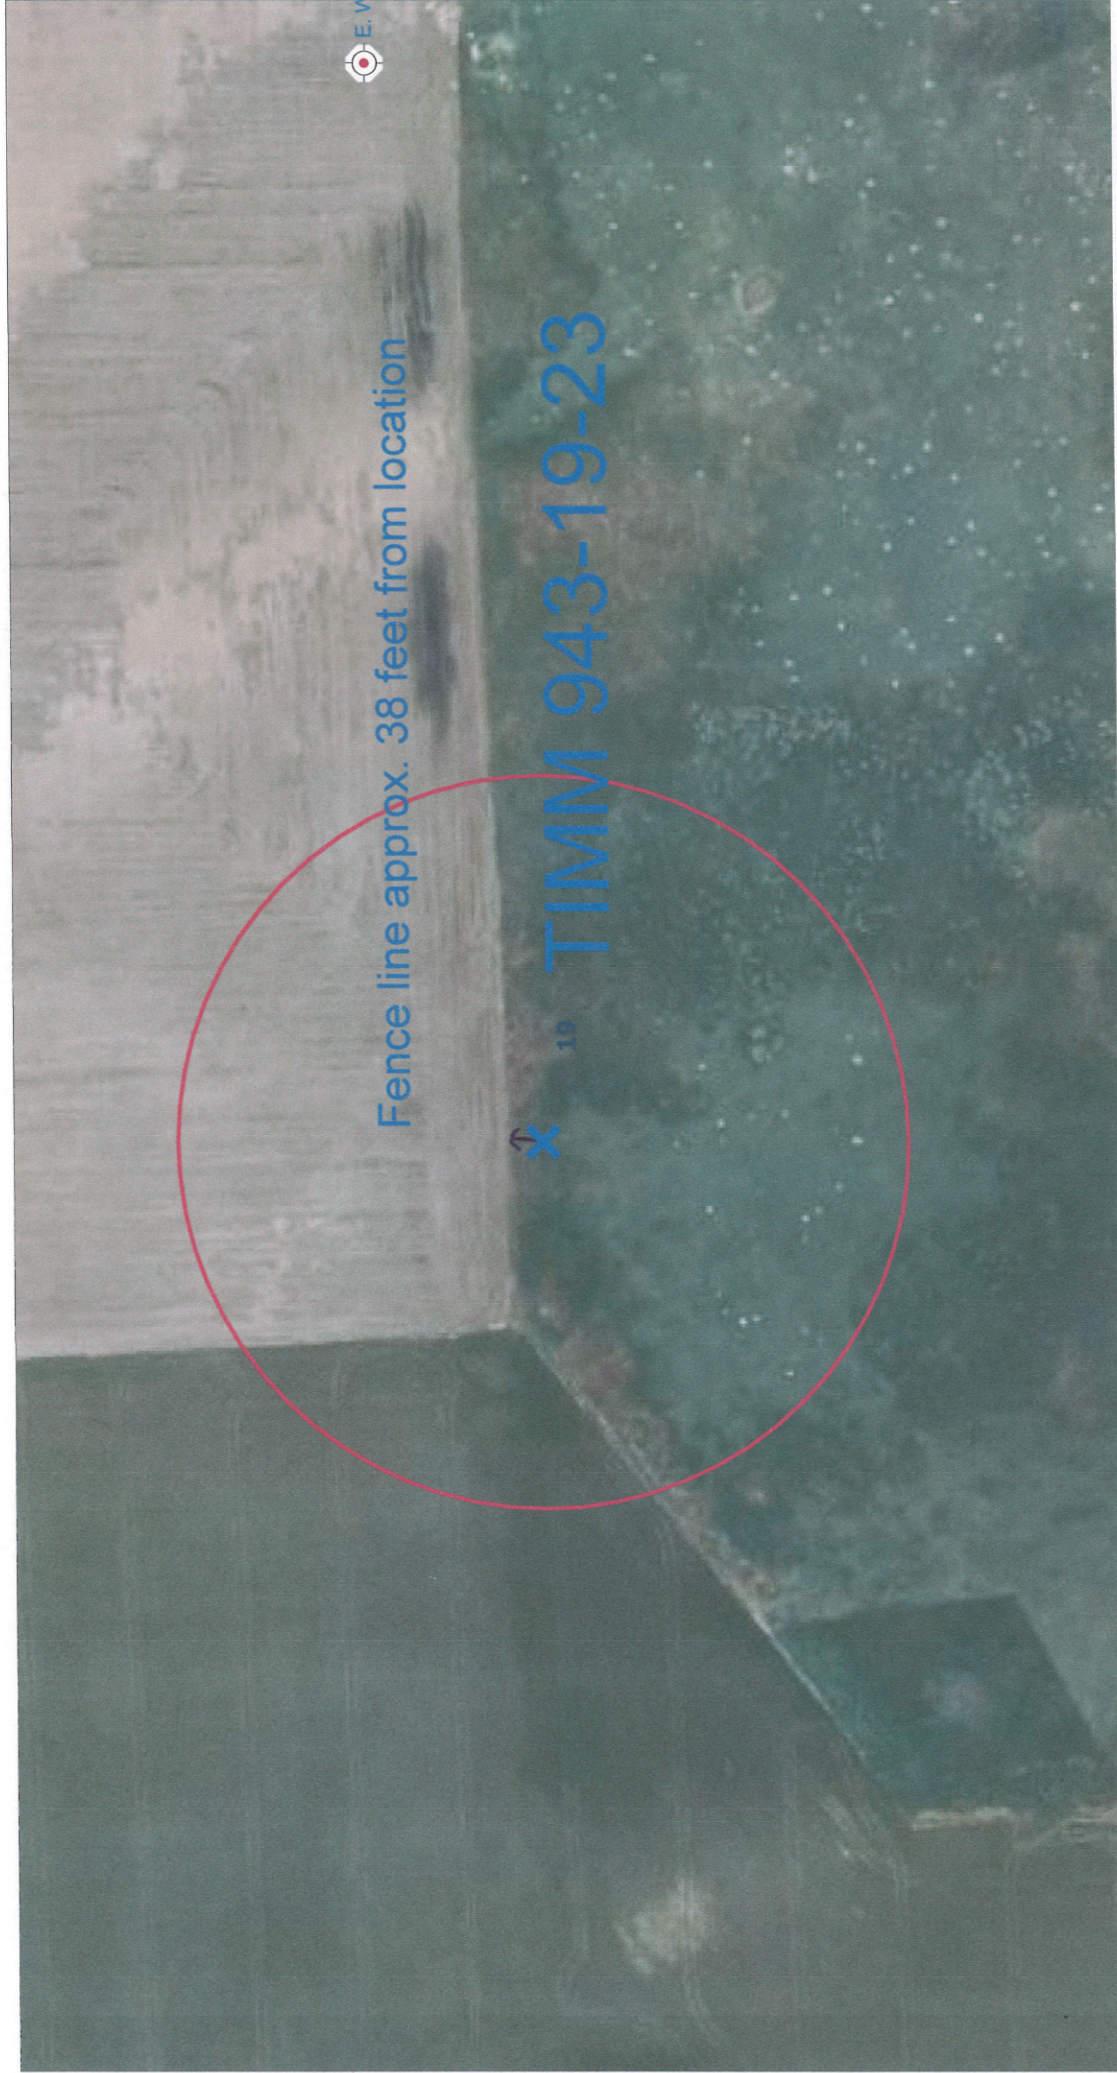

Fence line approx. 38 feet from location

19

TIMM 943-19-23

SCALE 1 : 2,527

