

Petroleum Development Corporation

March 10, 2010

VIA Hand Delivery

Byron L. Spaur, Mark R. Spaur,
Steven J. Spaur
c/o 22605 WCR 15
Johnstown, CO 80534

Notice of Drilling Operations
PDC Well Names: Spaur 23-10D, 10BD, 10GD, 10HD, 10PD, 10QD

Township 4 North, Range 67 West, 6th P.M.
Section 10: S/2: Bottom hole Locations
Weld County, Colorado
(See Map Attached for Locations)

Received by: Mark R. Spaur
Date: 3-30-10
Mark R. Spaur

Gentlemen:

Reference is made to prior notice letters and communication we have had on your lands, as captioned. As we have added some proposed well locations, we wanted to provide you with this new notice letter. Therefore, in accordance with the requirement of Rule 305 e.(1).B. of the Colorado Oil and Gas Conservation Commission (COGCC), this letter serves as a 30-day notice by Petroleum Development Corporation (PDC), of its intention to conduct drilling operations on the captioned wells.

I will be contacting you shortly to schedule a consultation to discuss the location of the well(s), access roads, production facilities and other related matters; however the well locations may be staked prior to a consultation. Pursuant to Rule 306, you may also use the enclosed postage prepaid postcard to request a consultation or to designate a representative for surface consultation. Also enclosed is a site diagram that depicts the area, per COGCC rules, within which the well(s) may be located, and the proposed location of the well(s), access road(s), and production facilities. Additionally, enclosed please find a copy of the COGCC's brochure describing surface owner rights and responsibilities, and a copy of the COGCC's on-site inspection policy.


As surface owner you have the responsibility for notifying any affected tenant farmer, lessee or other party that may own or have an interest in any crops or surface improvements that could be affected by these proposed operations. Should you have any questions regarding our operations or this notice, please feel free to contact me at contact me at (303) 517-3010.

Sincerely,
PETROLEUM DEVELOPMENT CORPORATION


Mac Neumann, Agent
cc: Carrie Eggleston
Sarah Garrett

CORPORATE OFFICE:
Petroleum Development Corporation
1775 Sherman Street, Suite 3000
Denver, CO 80203
303-860-5800

BRIDGEPORT OFFICE:
Petroleum Development Corporation
120 Genesis Boulevard • P.O. Box 26
Bridgeport, WV 26330
304-842-3597

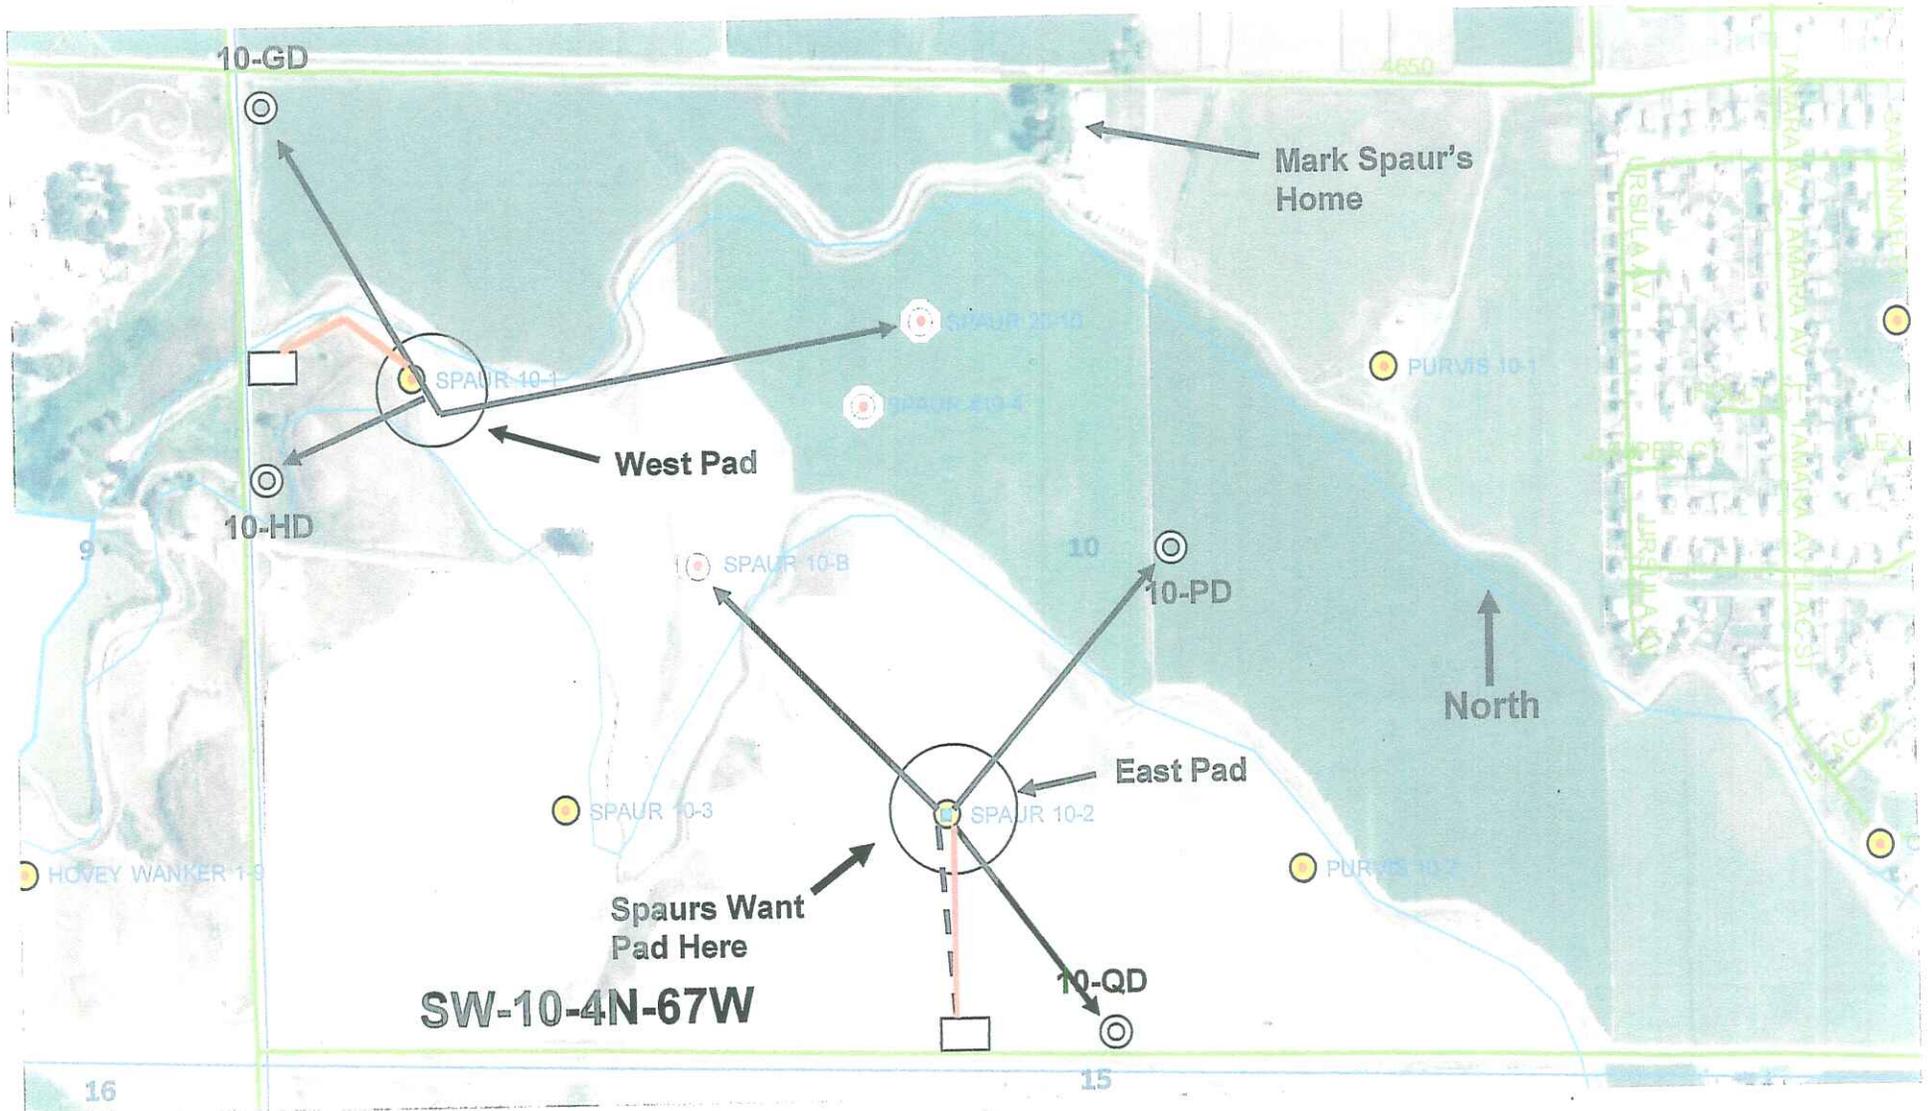

- Includes 3 new wells being directionally drilled from West Pad including the Spaur 23-10
- Also includes 3 more new wells being directionally drilled from East Pad including the Spaur 10B.

Surface Owners (Spaurs) preferred drilling plan. All 6 new wells would be directionally drilled from existing well areas. No straight holes.

Surface Owner: MARK SPAUR
Phone #: 970 890-9298
Well Name(s): SP44-23-10D, 10B0, 10E0, 10H0, 10P0, 10Q0

Check Appropriate Box(s):

- I do not want a consultation.
- I do want to be consulted concerning proposed operations.
- I want to appoint a Tenant to be consulted.

Tenant

Name: _____
Phone #: _____
Address: _____