

SUNDRY NOTICE

Submit original plus one copy. This form is to be used for general, technical and environmental sundry information. For proposed or completed operations, describe in full on Technical Information Page (Page 2 of this form.) Identify well or other facility by API Number or by OGCC Facility ID. Operator shall send an informational copy of all sundry notices for wells located in High Density Areas to the Local Government Designee (Rule 603b.)

1. OGCC Operator Number: 96850	4. Contact Name: Howard Harris	Complete the Attachment Checklist OP OGCC
2. Name of Operator: Williams Production RMT Company	Phone: 303-606-4086	
3. Address: 1515 Arapahoe St., Tower 3, #1000 City: Denver State: CO Zip: 80202	Fax: 303-629-8272	
5. API Number 05-045-18074-00	OGCC Facility ID Number	Survey Plat
6. Well/Facility Name: Federal	7. Well/Facility Number RWF 514-19	Directional Survey
8. Location (Qtr/Tr, Sec, Twp, Rng, Meridian): NWSW Section 19-T6S-R94W 6th PM		Surface Eqpmt Diagram
9. County: Garfield	10. Field Name: Rulison	Technical Info Page X
11. Federal, Indian or State Lease Number: COC62160		Other Well Bore Diagram X

General Notice

CHANGE OF LOCATION: Attach New Survey Plat (a change of surface qtr/qtr is substantive and requires a new permit)

Change of Surface Footage from Exterior Section Lines:	<input type="checkbox"/>	FNL/FSL	<input type="checkbox"/>	FEL/FWL	<input type="checkbox"/>
Change of Surface Footage to Exterior Section Lines:	<input type="checkbox"/>	FSL	<input type="checkbox"/>	FWL	<input type="checkbox"/>
Change of Bottomhole Footage from Exterior Section Lines:	<input type="checkbox"/>	FNL	<input type="checkbox"/>	FWL	<input type="checkbox"/>
Change of Bottomhole Footage to Exterior Section Lines:	<input type="checkbox"/>	FNL	<input type="checkbox"/>	FWL	<input type="checkbox"/>

Bottomhole location Qtr/Tr, Sec, Twp, Rng, Mer _____ attach directional survey

Latitude _____ Distance to nearest property line _____ Distance to nearest bldg, public rd, utility or RR _____
 Longitude _____ Distance to nearest lease line _____ Is location in a High Density Area (rule 603b)? Yes/No **NO**
 Ground Elevation _____ Distance to nearest well same formation _____ Surface owner consultation date: _____

GPS DATA:
 Date of Measurement _____ PDOP Reading _____ Instrument Operator's Name _____

CHANGE SPACING UNIT

Formation	Formation Code	Spacing order number	Unit Acreage	Unit configuration

Remove from surface bond
Signed surface use agreement attached

CHANGE OF OPERATOR (prior to drilling):
 Effective Date: _____
 Plugging Bond: Blanket Individual

CHANGE WELL NAME **NUMBER**
 From: _____
 To: _____
 Effective Date: _____

ABANDONED LOCATION:
 Was location ever built? Yes No
 Is site ready for inspection? Yes No
 Date Ready for Inspection: _____
Location is used by five additional wells and will be reclaimed at a latter date

NOTICE OF CONTINUED SHUT IN STATUS
 Date well shut in or temporarily abandoned: _____
 Has Production Equipment been removed from site? Yes No
 MIT required if shut in longer than two years. Date of last MIT _____

SPUD DATE: _____ **REQUEST FOR CONFIDENTIAL STATUS** (6 mos from date casing set)

SUBSEQUENT REPORT OF STAGE, SQUEEZE OR REMEDIAL CEMENT WORK *submit cbl and cement job summaries

Method used	Cementing tool setting/perf depth	Cement volume	Cement top	Cement bottom	Date

RECLAMATION: Attach technical page describing final reclamation procedures per Rule 1004.
 Final reclamation will commence on approximately _____ Final reclamation is completed and site is ready for inspection.

Technical Engineering/Environmental Notice

Notice of Intent Report of Work Done
 Approximate Start Date: 7/1/10 Date Work Completed: _____

Details of work must be described in full on Technical Information Page (Page 2 must be submitted.)

<input type="checkbox"/> Intent to Recomplete (submit form 2)	<input type="checkbox"/> Request to Vent or Flare	<input type="checkbox"/> E&P Waste Disposal
<input type="checkbox"/> Change Drilling Plans	<input type="checkbox"/> Repair Well	<input type="checkbox"/> Beneficial Reuse of E&P Waste
<input type="checkbox"/> Gross Interval Changed?	<input type="checkbox"/> Rule 502 variance requested	<input type="checkbox"/> Status Update/Change of Remediation Plans
<input type="checkbox"/> Casing/Cementing Program Change	<input checked="" type="checkbox"/> Other: P & A	for Spills and Releases


I hereby certify that the statements made in this form are, to the best of my knowledge, true, correct and complete.

Signed: Howard Harris Date: 5/27/10 Email: Howard.Harris@Williams.com
 Print Name: Howard Harris Title: Sr. Regulatory Specialist

COGCC Approved: David And Title PE II Date: 7/7/2010

CONDITIONS OF APPROVAL, IF ANY:

TECHNICAL INFORMATION PAGE

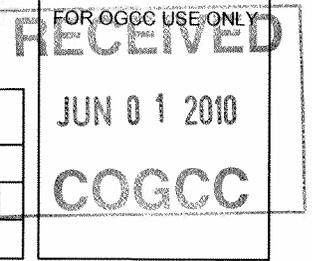

1. OGCC Operator Number: _____ 96850 _____ API Number: 05- 045-18074-00
2. Name of Operator: <u>Williams Production RMT Company</u> OGCC Facility ID # _____
3. Well/Facility Name: <u>Federal</u> Well/Facility Number: <u>RWF 514-19</u>
4. Location (QtrQtr, Sec, Twp, Rng, Meridian): <u>NWSW Section 19-T6S-R94W 6th PM</u>


This form is to be completed whenever a Sundry Notice is submitted requiring detailed report of work to be performed or completed. This form shall be transmitted within 30 days of work completed as a "subsequent" report and must accompany Form 4, page 1.

5. **DESCRIBE PROPOSED OR COMPLETED OPERATIONS**

While fracing the well during initial completion, the casing burst at 4316'. A cement squeeze was performed and a casing patch was installed. The casing was pressure tested and failed. a caliper was ran and results showed the casing patch failed and in addition another hole was discovered at 5122'. It was assumed that the entire string of casing was bad and the well had a good chance of developing additional holes. Due to the high risk and difficulty in completing the next 6 stages, a decision was made to plug the well and develop the reserves from another well.

See attached form 6 as well as procedure and well bore shcematics.

WILLIAMS PRODUCTION RMT CO.
PROCEDURE - P&A Well

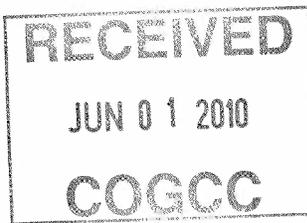

DATE: 5/25/10
WELL (API): RWF 514-19 (05-045-18074) UNIQUE #: 62280386
PROSPECT: Rulison COUNTY AND STATE: Garfield, CO
LOCATION: Section 19, T6S R94W PAD: RWF 13-19
ENG. CONTACT: J Putnam (cell: 303-319-2280) AFE AMOUNT: drill AFE
OBJECTIVE: Plug well, retrieve upper portion of 4-1/2" csg if it fails pressure test
SPUD: 1/3/10
PROD CASING: 4.5" 11.6# I-80 Csg Prop: ID = 4.000", 7780 psi burst, capacity = 0.08726ft³/ft
SURF CASING: 9-5/8" 32.3# H-40 Csg Prop: ID = 9.001", capacity = 0.442 ft³/ft
CAPACITY: 4-1/2" to 9-5/8" ann cap = 0.331 ft³/ft ; 8-3/4" OH capacity = 0.418 ft³/ft
PBD / LAST TAG: CBP SET AT 7473'

Note: All Cement has to be at least Class G 15.8 ppg (1.15 ft³/sack)

**** Regulatory: This is a federal well. We need both BLM and COGCC approval of this procedure before we proceed on plugging the well**

PLUG LOWER SECTION OF WELL

- 1) Notify COGCC / BLM Representatives of start of activity
- 2) MIRU workover rig
- 3) RIH and circulate hole with **12.75 ppg** mud
- 4) Dump bail 4 sx of cement on the existing plug at 7473', ~ 50'
- 5) Set BP at 5050'
- 6) Dump bail 4 sx of cement on the plug, ~ 50'
- 7) Set CIBP at 4210'
- 8) Dump bail 4 sx of cement on the plug, ~ 50'
- 9) Shut well in , WOC 12 hrs
- 10) Pressure test 4-1/2" csg to 500 psi for 30 minutes
- 11) If Pressure test holds then proceed, if not , discuss with engineering

TEST UPPER CASING FOR BAD JOINTS

- 12) Pipe bradenhead to pit or tank
- use hard line and put two valves in tandem to control flowback if it occurs
- 13) Rig up pump truck
- 14) Bring pressure slowly up to 7400 psi (95% of burst rating)
- 15) Hold pressure for 15 minutes, then bleed off pressure
- 16) Again, bring up pressure slowly to 7400 psi
- 17) Hold pressure for 15 minutes, then bleed off pressure
* Repeat for a total of 4 times
- 18) If pressure holds, then proceed to step 19a, if casing fails then proceed to step 19b


PLUG UPPER CASING - UPPER 4-1/2" CSG PRESS TEST PASSED

- 19 a) Shoot two sqz holes at 1175' (50' below 9-5/8" csg)
- 20 a) Set **cmt retainer** at 1070'
- 21 a) Attempt to squeeze surf. csg shoe with 40 sx cement through retainer
- if no injection is established, spot 20 sx of cement on retainer
- 22 a) Spot 4 sx of cmt on top of retainer (~ 50')
- 23 a) Cut off 9 5/8" and 4-1/2" casing to 4-ft below surface.
- 24 a) Run 3 jts tubing inside the 4-1/2" casing - pump balanced plug to surface
- 25 a) Run 3 jts tubing outside the 4-1/2" casing - pump balanced plug to surface
- 26 a) Weld in place "plate style" dryhole marker
- 27 a) Top fill casing with 2 sx cement
- 28 a) Backfill cellar and reseed disturbed area as appropriate

RETRIEVE 4-1/2" CASING & PLUG UPPER HOLE SECTION - UPPER 4-1/2" CSG PRESS TEST FAILED

- 19 b) RIH w/ workstring and 4-1/2' packer
- 20 b) Set packer above plug at ~ 4100'

- 21 b) Pump down tbg then annulus to confirm csg has failed
 - using packer move up csg to identify location of hole
- 22 b) Once hole is located, then determine joint/collar to pull (run free point if required)
 - remove at least one good joint below the hole, and at a minimum, 100' below the surf csg shoe
- 23 b) RU E-line
- 24 b) RIH w/ primer cord to chosen collar and set off to loosen collar
- 25 b) RD E-line
- 26 b) Back off casing and remove from well
 - tag and store burst section of casing for pipe manufacturer analysis
- 27 b) Spot stub plug 50' below casing top and 50' above casing top (100' plug total) - use 2% CaCl in cement
- 28 b) Wait 4 hrs. Tag plug.
- 29 b) Spot cmt plug 50' below surface casing shoe to 50' above casing shoe (100' plug total) - use 2% CaCl in cement
- 30 b) Wait 4 hrs. Tag plug.
- 31 b) Cut off 9 5/8" casing to 4-ft below surface.
- 32 b) Run 3 jts tubing inside the 9-5/8" casing - pump balanced plug to surface
- 33 b) Weld in place "plate style" dryhole marker
- 34 b) Top fill casing with 2 sx cement
- 35 b) Backfill cellar and reseed disturbed area as appropriate

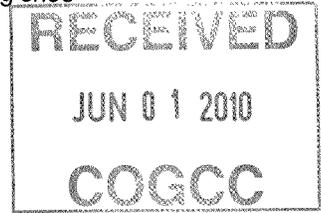

RECEIVED
 JUN 01 2010
 COGCC

WILLIAMS PRODUCTION RMT CO.

WELL SCHEMATIC

- Current Condition



LEASE & WELL NO. RWF 514-19
 FIELD NAME Rulison
 LOCATION Section 19, T6S R94W

DATE 5/19/10
 COUNTY & STATE Garfield, CO
 API NO. 05-045-18074

K.B. ELEV. 5756'
 D.F. ELEV. 5755'
 GROUND LEVEL 5733'
 CORR. _____

HOLE 13-1/2"
 SIZE

SURFACE CASING

SIZE 9 5/8" WEIGHT 32.# DEPTH 1124'
 GRADE H-40 SX. CMT. 320 sx TOC @ surf

Homco Csg Patch: 3.70" ID
 set at 4300' to 4360'

HOLE 8 3/4"
 SIZE

Hole in Csg: 4316'
 Hole in Patch: 4317'

Cmt Sqz at 4270' to 4342'

Hole in Csg: 5122'

PRODUCTION CASING

SIZE 4.5 " WEIGHT 11.6# DEPTH 8545'
 GRADE I-80 SX. CMT. 1225 sx TOC @ 5,100


8K Comp. Plug at 7473'
 8K Comp. Frac Plug (w/ ball) at 7475'
 8K Comp. Frac Plug (w/ ball) at 7750'
 8K Comp. Frac Plug (w/ ball) at 8074'

PBTD @ _____
 Drillers TD @ 8462'

MV1: 7510-7731'

Cameo: 7807-8056'

LC: 8161-8313'

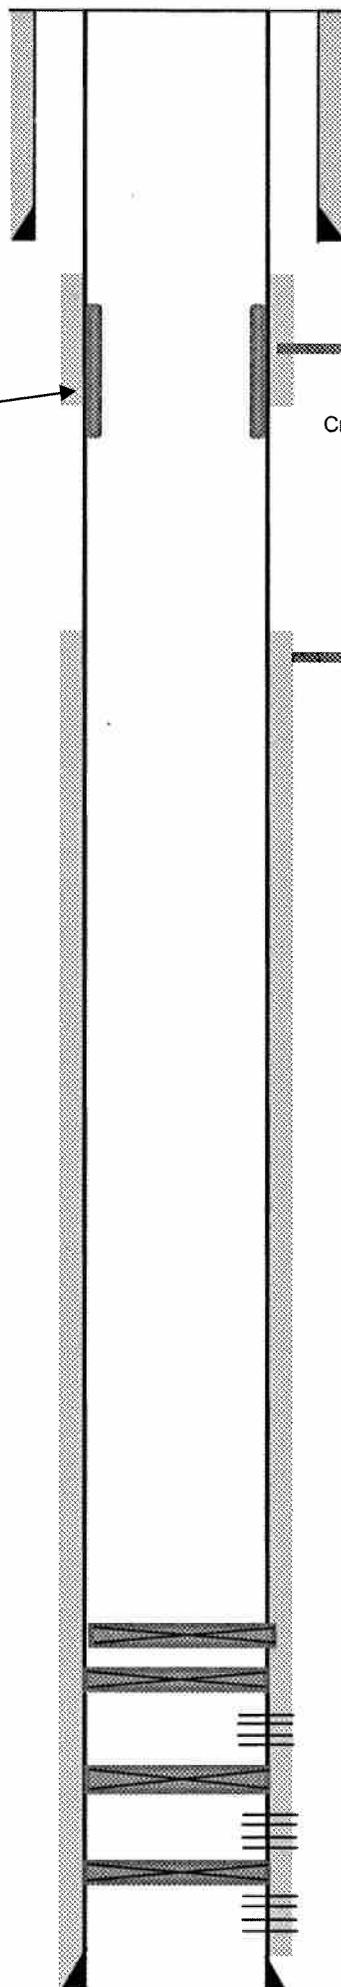

WILLIAMS PRODUCTION RMT CO.
WELL SCHEMATIC
P&A *PROPOSED*



LEASE & WELL NO. RWF 514-19
 FIELD NAME Rulison
 LOCATION Section 19, T6S R94W


DATE 5/19/10
 COUNTY & STATE Garfield, CO
 API NO. 05-045-18074

K.B. ELEV. 5756'
 D.F. ELEV. 5755'
 GROUND LEVEL 5733'
 CORR. _____

HOLE SIZE 13-1/2"

SURFACE CASING

SIZE 9 5/8" WEIGHT 32.# DEPTH 1124'
 GRADE H-40 SX. CMT. 320 sx TOC @ surf

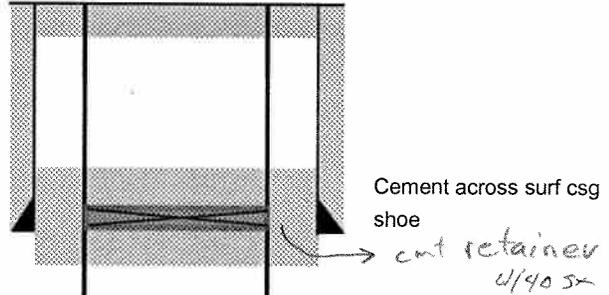

Homco Csg Patch: 3.70" ID
 set at 4300' to 4360'

** May pull 4-1/2' csg if it bursts

50' of cmt (4 sx)
 CIBP at 4210'

Hole in Csg: 4316'
 Hole in Patch: 4317'

Cmt Sqz at 4270' to 4342'

PRODUCTION CASING

SIZE 4.5 " WEIGHT 11.6# DEPTH 8545'
 GRADE I-80 SX. CMT. 1225 sx TOC @ 4898'

Top of MV: 4969'

HOLE SIZE 8 3/4"

Top of Gas: 6043'

50' of cmt (4 sx)
 Bridge Plug at 5050'

Hole in Csg: 5122'

50' of cmt (4 sx)

8K Comp. Plug at 7473'
 8K Comp. Frac Plug (w/ ball) at 7475'
 8K Comp. Frac Plug (w/ ball) at 7750'
 8K Comp. Frac Plug (w/ ball) at 8074'

MV1: 7510-7731'

Cameo: 7807-8056'

PBTD @ 8517'
 Drillers TD @ 8565'

LC: 8161-8313'

