


WELL LOCATION FOR MERCHANT ENERGY PARTNERS, LLC

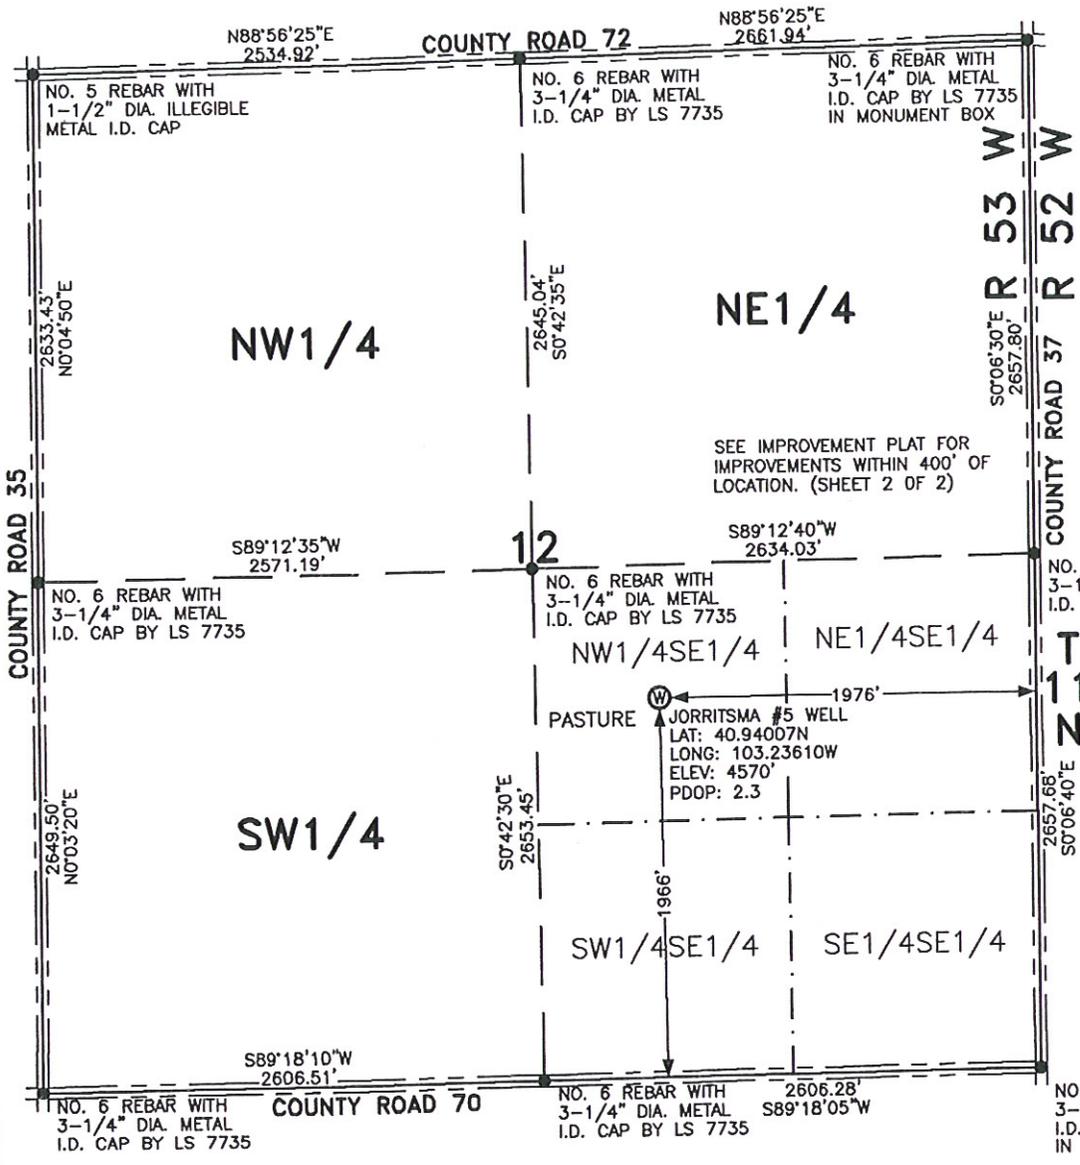

NOTES

BEARINGS SHOWN HEREON ARE BASED UPON RTK GPS OBSERVATIONS.

SEE IMPROVEMENT PLAT FOR IMPROVEMENTS WITHIN 400' OF LOCATION. (SHEET 2)

USGS QUAD MAP: PADRONI NW, COLO.

LAT/LONG VALUES ARE NAD83


ELEVATIONS BASED ON NAVD 1988

ALL DISTANCES TO SECTION LINES ARE MEASURED PERPENDICULAR TO AND ARE AT RIGHT ANGLES TO SAID SECTION LINES.

LEGEND

- FIELD SURVEYED WELL LOCATION
- ROAD
- FENCE

THIS WELL LOCATION PLAT HAS BEEN PREPARED FOR MERCHANT ENERGY PARTNERS, LLC, TO LOCATE THE JORRITSMA #5 WELL BEING 1976 FEET FROM THE EAST LINE AND 1966 FEET FROM THE SOUTH LINE IN THE NW1/4SE1/4 OF SECTION 12, TOWNSHIP 11 NORTH, RANGE 53 WEST OF THE 6TH P.M., LOGAN COUNTY, COLORADO. THE SURFACE ELEVATION AT THIS POINT IS 4570 FEET. THIS IS NOT A LAND SURVEY PLAT.

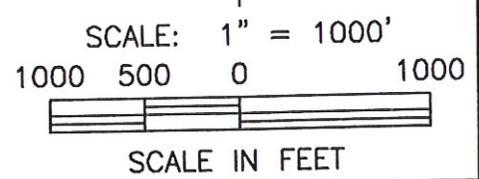

LEIBERT-McATEE & ASSOCIATES, INC.
 P.O. BOX 442 615 SOUTH TENTH AVENUE
 STERLING, CO 80751 970-522-1960

FIELD DATE: 6-8-10	DWG DATE: 6-14-10	GPS OPERATOR: DARREN VEAL
JORRITSMA #5	DWG NO. 1526-09	SHEET 1 OF 2