


BM 35L
PAD LOCATION

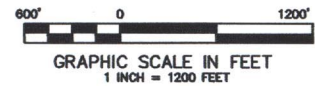


 SECTION CORNER LOCATION
BASED ON GLO RECORD
INFORMATION
 FIELD SURVEYED SECTION
CORNER LOCATIONS
 FIELD SURVEYED WELL
LOCATION
 CALCULATED BOTTOM
HOLE LOCATION

REFERENCE NOTES

- ## SURVEYOR'S CERTIFICATE

on, and that this Plat represents



P.L.S. 27925

COLORADO P.L.S. 27925



VIEW: 1B

SURVEYED: 10/06/09	SCALE: 1" = 1200'
DRAFTED: 01/18/10	DWG: Noble\2006\BM35L
CHECKED: 01/19/10	SHEET: 1 of 10