

# LOCATION DRAWING


DALEY LAND SURVEYING, INC.

PARKER, CO. 80134

303 953 9841

## PRODUCTION FACILITY VISIBLE IMPROVEMENTS SKETCH HERBST C22-24 & COLEMAN C22-21D

SECTION 22, TOWNSHIP 4 NORTH, RANGE 64 WEST OF THE 6TH PRINCIPAL MERIDIAN

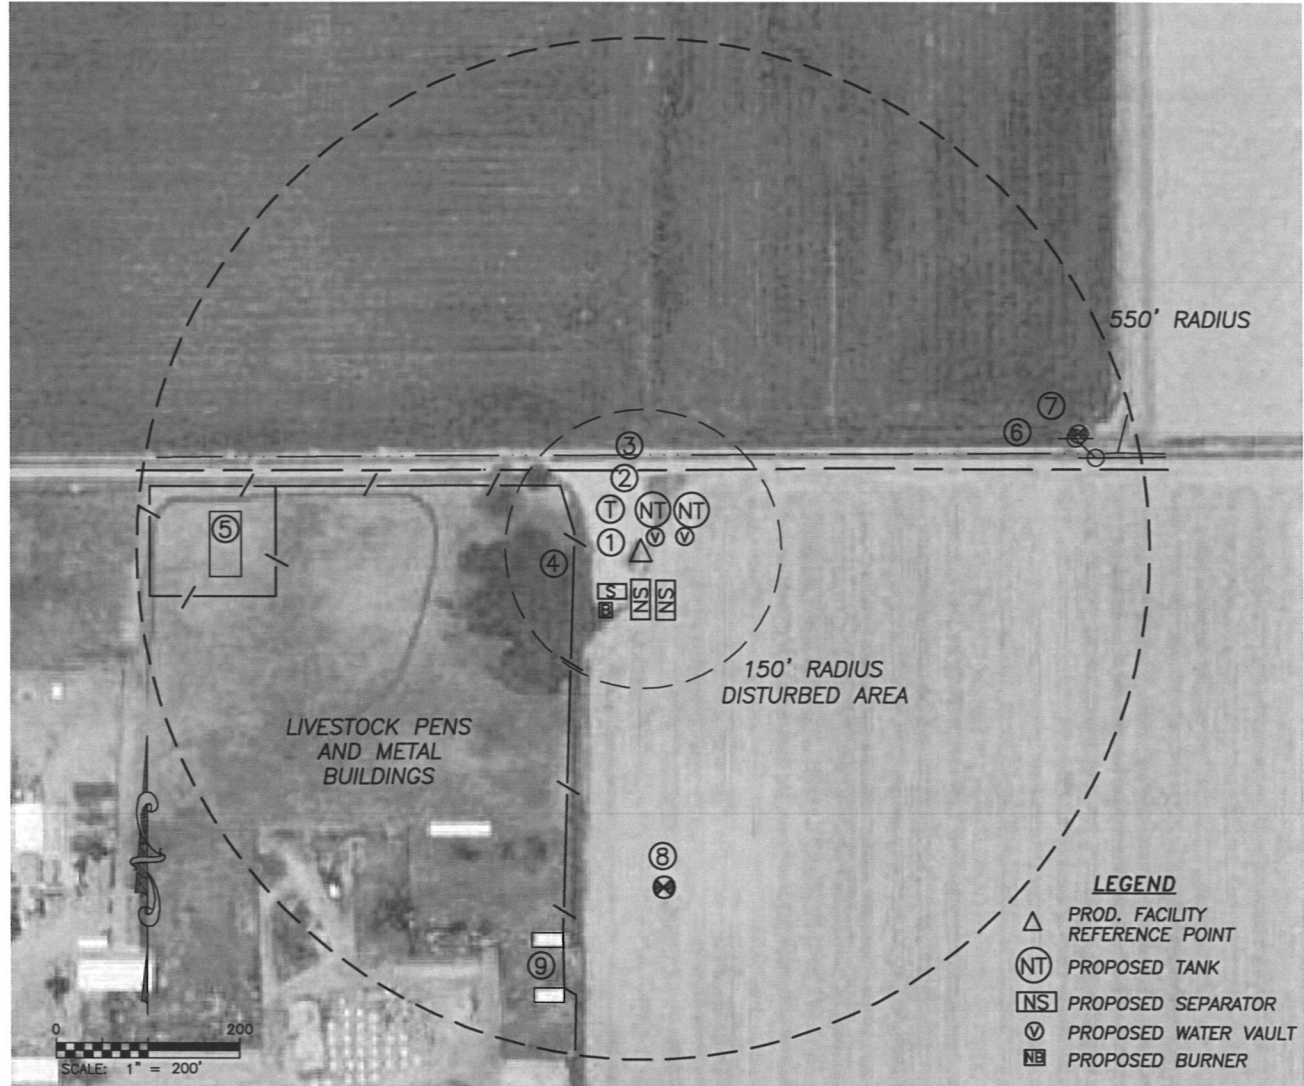

### REFERENCE POINT LOCATION:

LATITUDE: N40.29763°  
LONGITUDE: W104.54345°  
PDOP: 2.2

NW4/SW4 SEC 22

### ASSOCIATED EXISTING WELLS:

CANTRELL 1  
CANTRELL 22-12

### ASSOCIATED NEW WELLS:

HERBST C22-24  
COLEMAN C22-21D

①

PROD. FACILITY  
45'± NW

②

CENTERLINE  
FIELD ROAD  
85'± N

③

CONC. DITCH  
100'± N

④

WIRE FENCE  
75'± W

⑤

MODULAR HOME  
440'± W

⑥

OVERHEAD  
POWER  
485'± E

⑦

WATER WELL  
490'± E

⑧

WELL:  
CANTRELL 22-12  
365'± S

⑨

METAL SHED  
425'± SW  
480'± SW