


MULTI-WELL PLAN - NOBLE ENERGY

SECTION: 26
TOWNSHIP: 6N
RANGE: 65W

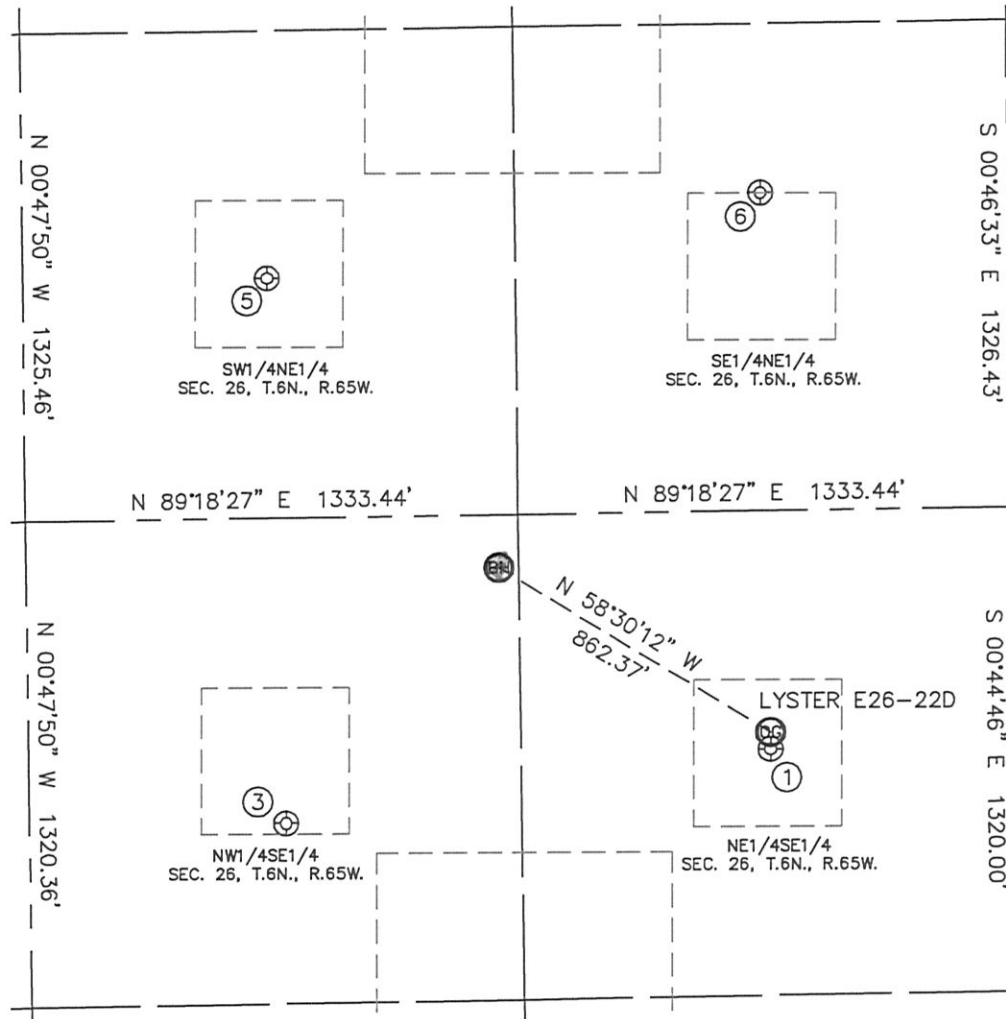

①

LYSTER 9-26EG
NE1/4SE1/4
1990' FSL
658' FEL
LAT-40.45514°N
LONG-104.62313°W
PDOP: 1.5
ELEV: 4688

③

LYSTER E26-10X
NW1/4SE1/4
1810' FSL
1972' FEL
LAT-40.45464°N
LONG-104.62785°W
PDOP: 1.9
ELEV: 4688

⑤

HOWARD E26-6
SW1/4NE1/4
2000' FNL
2007' FEL
LAT-40.45871°N
LONG-104.62799°W
PDOP: 1.8
ELEV: 4701

⑥

HOWARD 11-26EG
SE1/4NE1/4
1788' FNL
669' FEL
LAT-40.45930°N
LONG-104.62318°W
PDOP: 2.0
ELEV: 4695

