


COULSON TANK BATTERY LOCATION MAP

Township 4 North, Range 67 West, 6th P.M.
Section 2: E/2SW/4

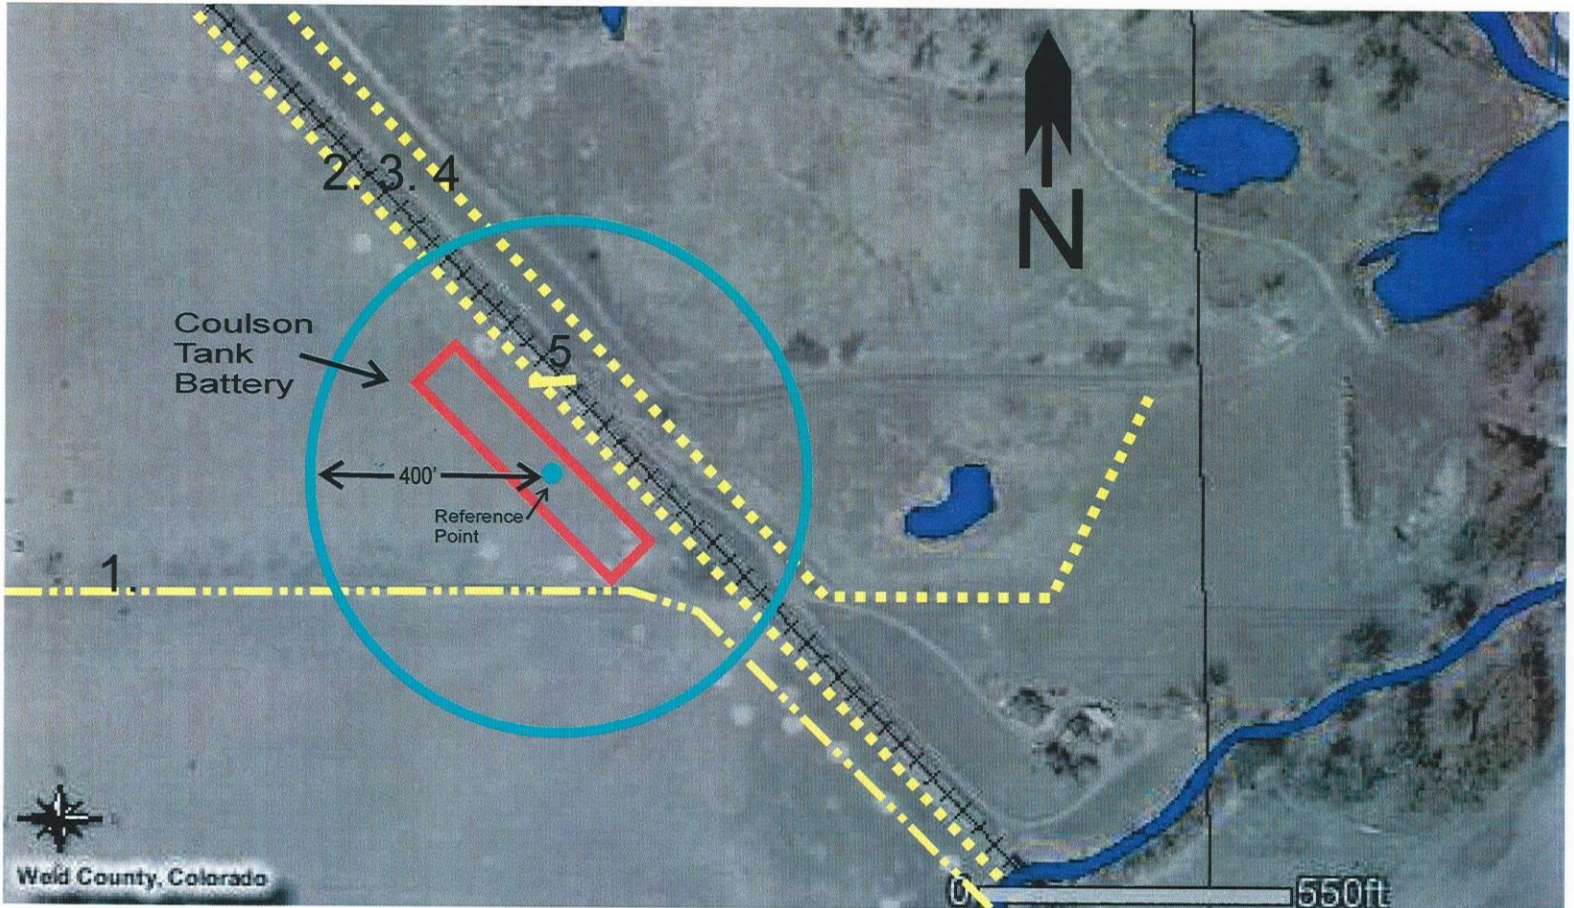

1. Xcel gas line 88' South of the Tank Battery Location.
2. Barb wire fence 103' East of Tank Battery Location.
3. Union Pacific Railroad 128' East of Tank Battery Location.
4. Barb wire fence 228' East of Tank Battery Location.
5. Unused culvert 218' East of Tank Battery Location.