

Steil Surveying Services, LLC


1102 West 19th Street P.O. BOX 2073

Cheyenne, Wyoming 82009

HYDROLOGY MAP

THIS MAP DOES NOT REPRESENT A BOUNDARY SURVEY

SECTION 3
TOWNSHIP 3 NORTH
RANGE 64 WEST

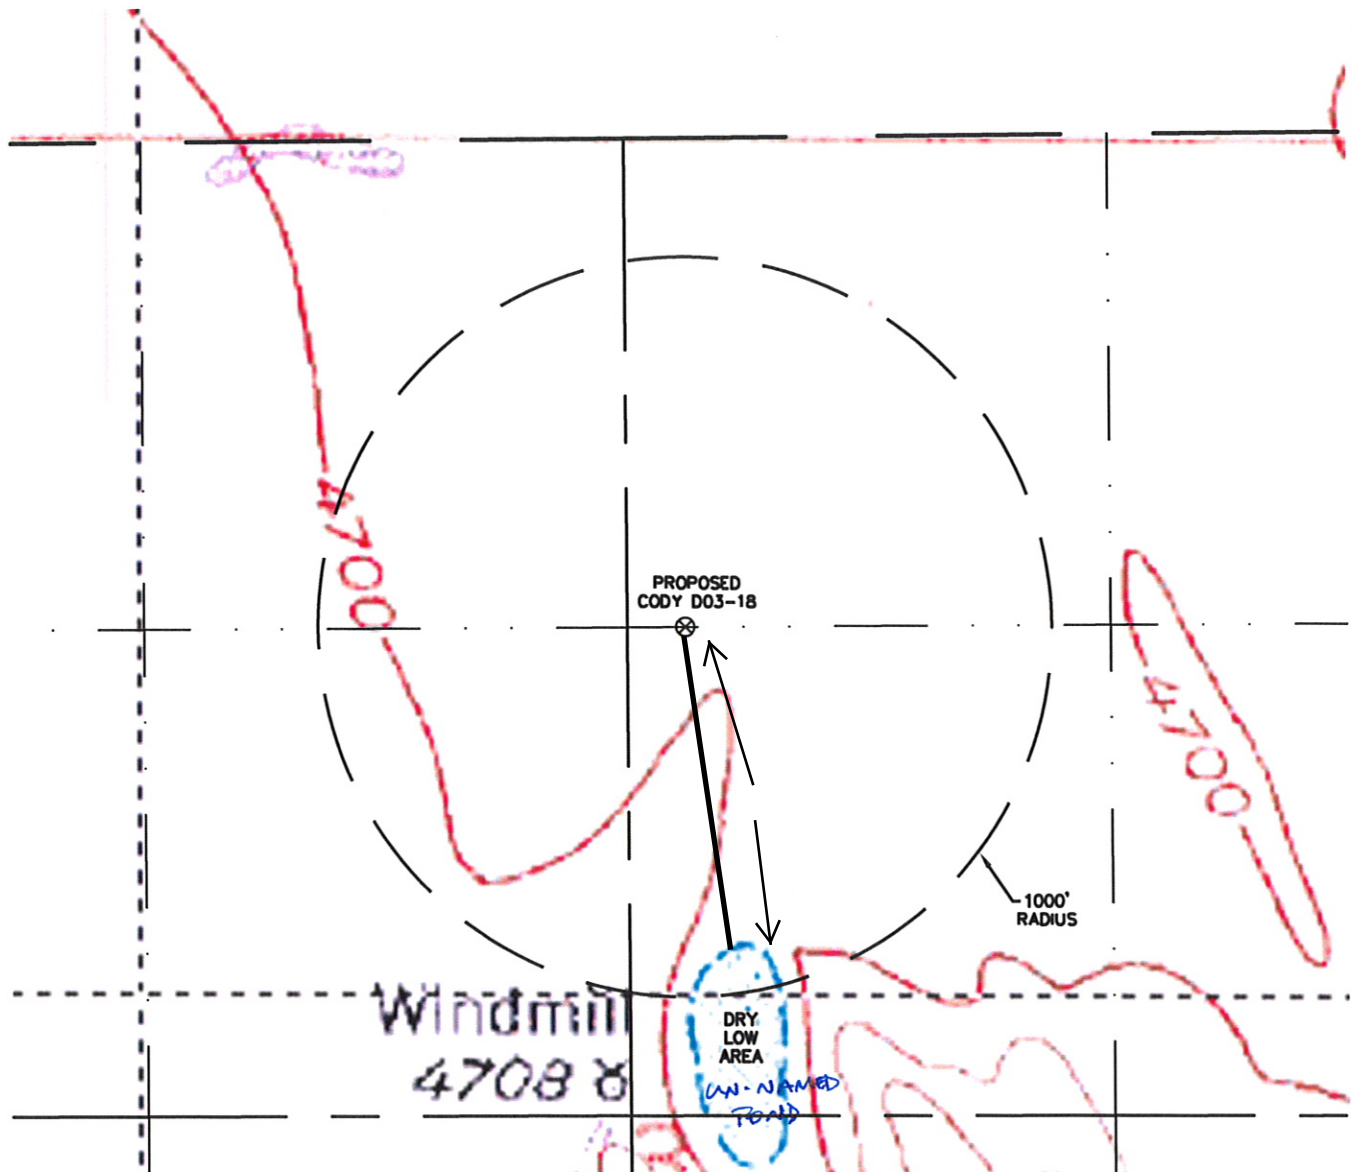

THERE IS NO VISIBLE SURFACE WATER WITHIN 1000'.

DATE: 03/05/2010

