


**MULTI-WELL PLAN - NOBLE ENERGY**

SECTION: 1  
TOWNSHIP: 3N  
RANGE: 65W

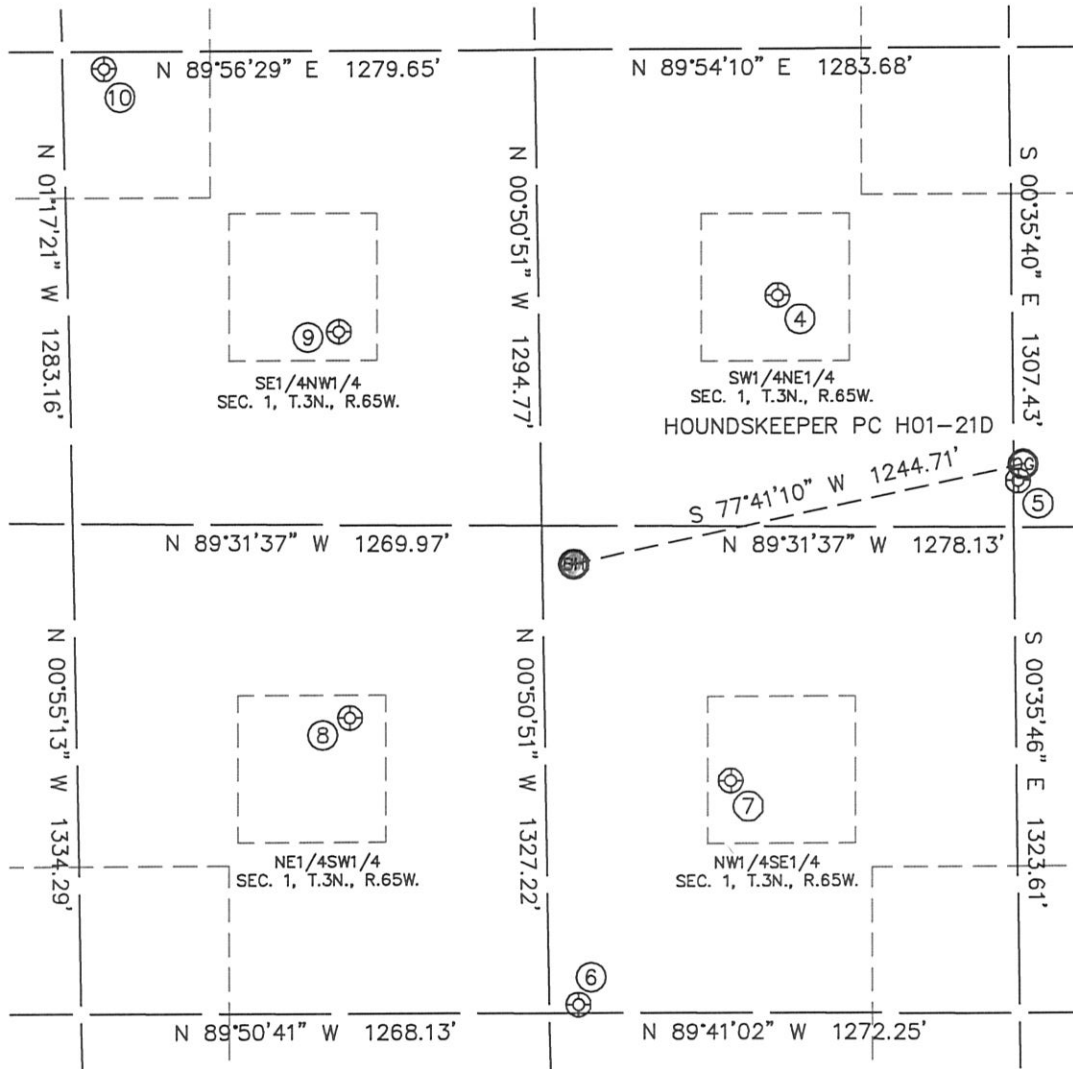

④  
HOUNDSKEEPER 1-13  
SW1/4NE1/4  
1978' FNL  
1915' FEL  
LAT-40.25606°N  
LONG-104.60933°W  
PDOP: 1.5  
ELEV: 4874

⑤  
HOUNDSKEEPER H 1-22  
SE1/4NE1/4  
2491' FNL  
1267' FEL  
LAT-40.25465°N  
LONG-104.60702°W  
PDOP: 1.8  
ELEV: 4871

⑥  
SHELTON H 1-24  
NW1/4SE1/4  
1350' FSL  
2466' FEL  
LAT-40.25078°N  
LONG-104.61133°W  
PDOP: 3.7  
ELEV: 4874

⑦  
UPRC 1-10J  
NW1/4SE1/4  
1958' FSL  
2050' FEL  
LAT-40.25244°N  
LONG-104.60983°W  
PDOP: 1.8  
ELEV: 4870

⑧  
UPRC 1-11J  
NE1/4SW1/4  
2135' FSL  
2010' FWL  
LAT-40.25295°N  
LONG-104.61352°W  
PDOP: 5.0  
ELEV: 4858

⑨  
LAURICE 6-1  
SE1/4NW1/4  
2063' FNL  
2004' FWL  
LAT-40.25583°N  
LONG-104.61359°W  
PDOP: 2.2  
ELEV: 4853

⑩  
SHELTON 18-1  
SE1/4NW1/4  
1340' FNL  
1391' FWL  
LAT-40.25782°N  
LONG-104.61584°W  
PDOP: 2.9  
ELEV: 4840