


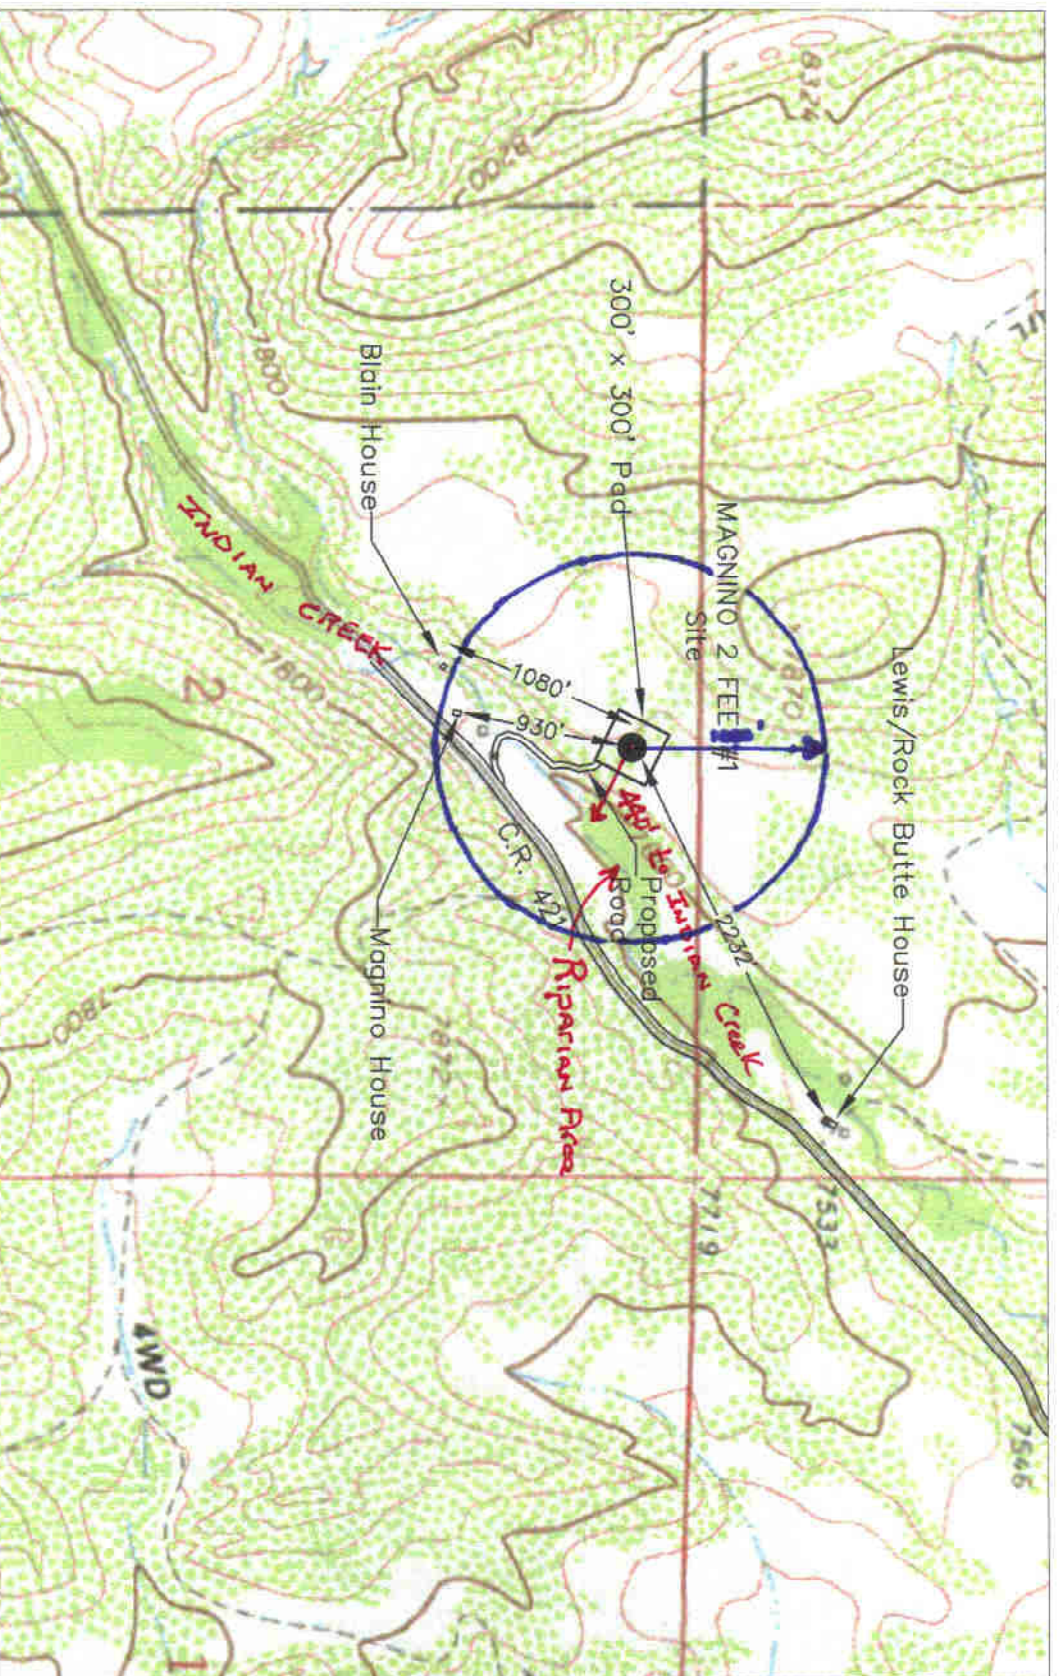

NORTH

MAGNINO 2 FEE #1

MANZANO, LLC



WELL LOCATION IS 440' NW OF INTERMITTENT STREAM NAMED INDIAN CREEK