


# VISIBLE IMPROVEMENTS SKETCH HOFF PC D06-22D

SECTION 6, TOWNSHIP 3 NORTH, RANGE 64 WEST OF THE 6TH PRINCIPAL MERIDIAN

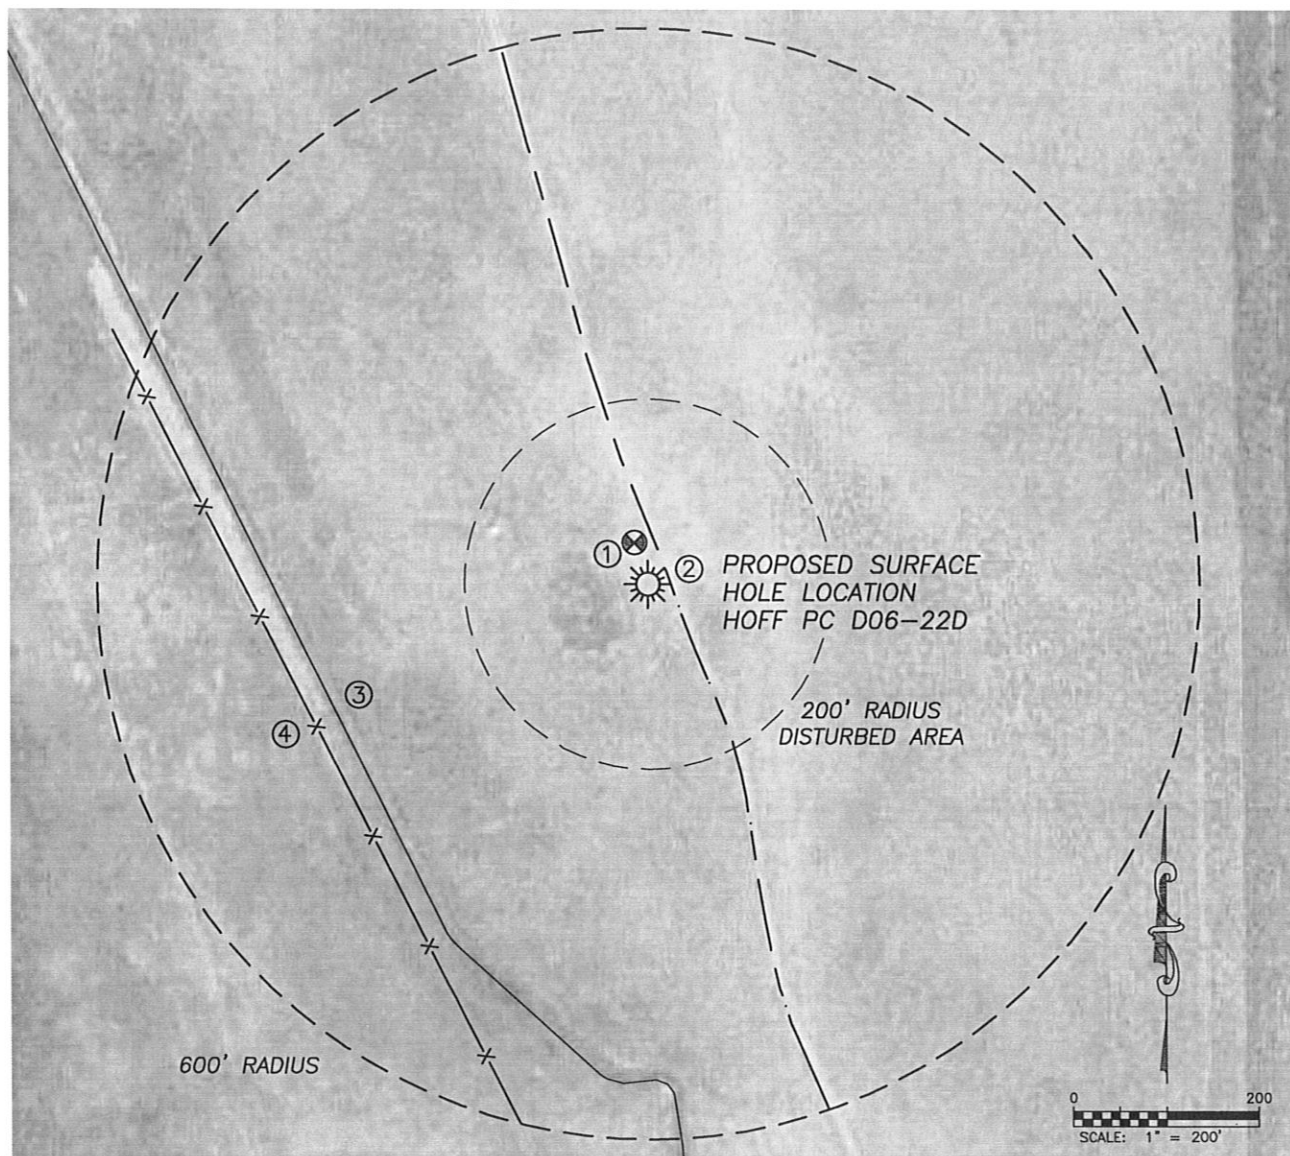

①

WELL  
MCKENNEY 6-14  
47'± N

②

CENTERLINE  
FIELD ROAD  
25'± E

③

IRRIG. DITCH  
365'± SW

④

WIRE FENCE  
390'± SW

NEAREST OVERHEAD POWER 2110'± N