


There are no visible improvements within 200 feet of the location, except an existing center pivot irrigation system.

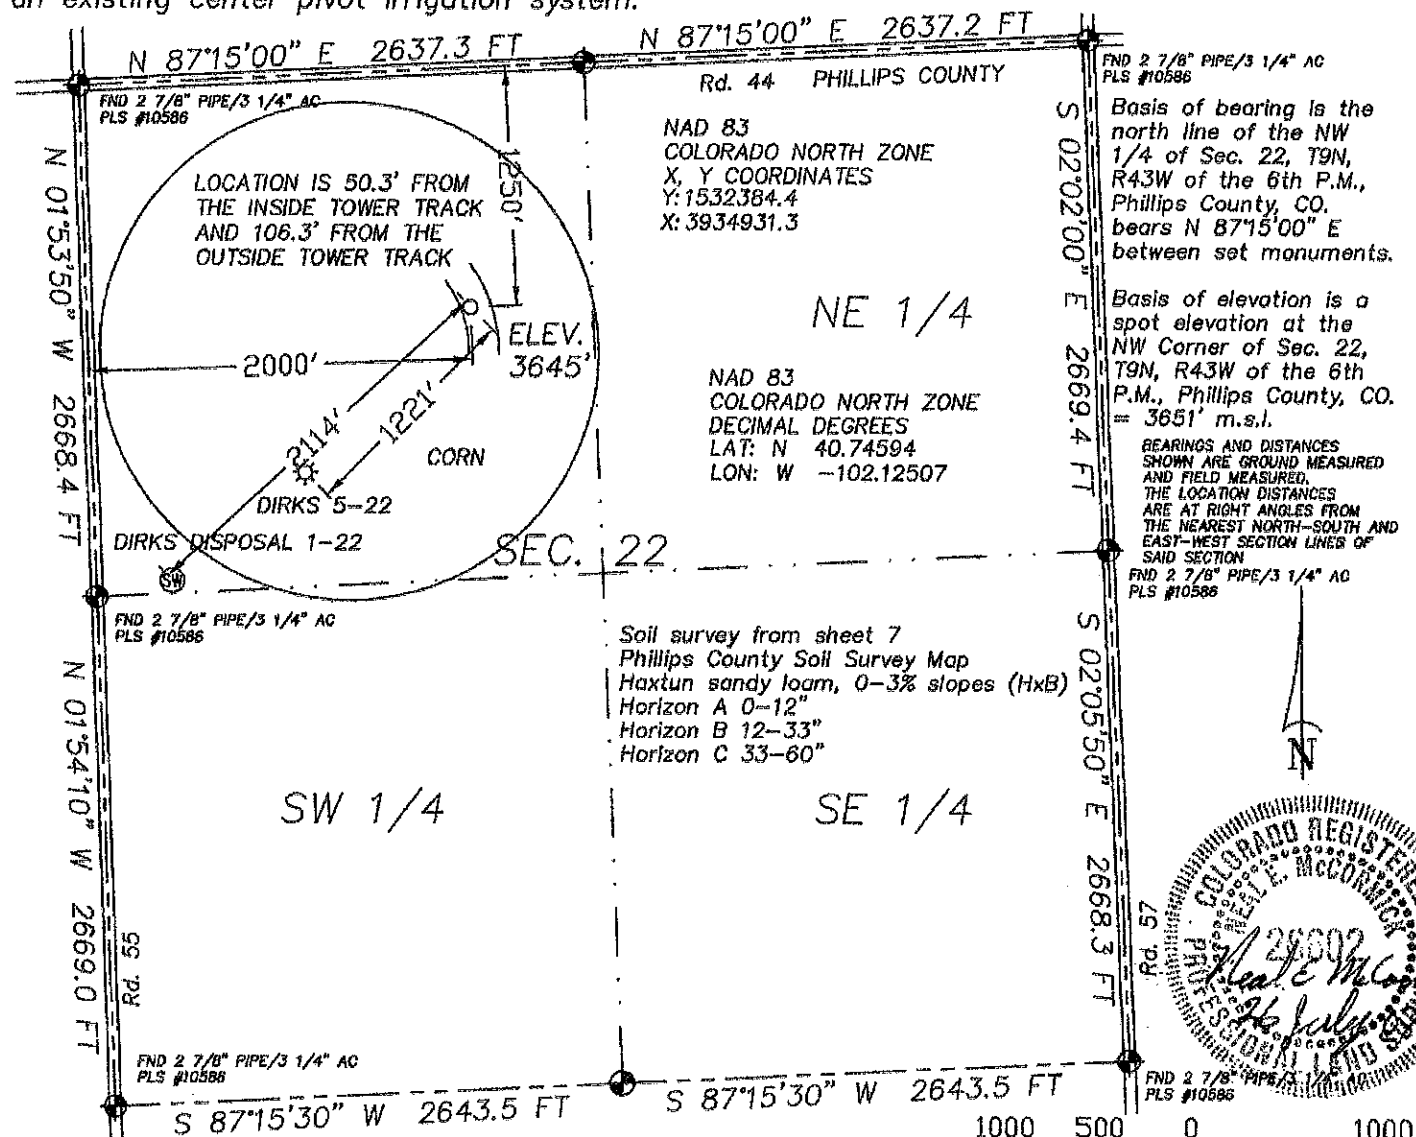

- Scale 1" = 1000'



GREAT PLAINS
SURVEYING, INC.

PHILLIPS COUNTY, COLORADO

P.O. Box 296 Phone 970-774-3602
Holyoke, CO 80734 Fax 970-774-3601