


DALEY LAND SURVEYING, INC.

PARKER, CO. 80134

303 953 9841

# PRODUCTION FACILITY VISIBLE IMPROVEMENTS SKETCH REI H08-13D, REI H08-21D & REI H08-24D

SECTION 8, TOWNSHIP 3 NORTH, RANGE 65 WEST OF THE 6TH PRINCIPAL MERIDIAN

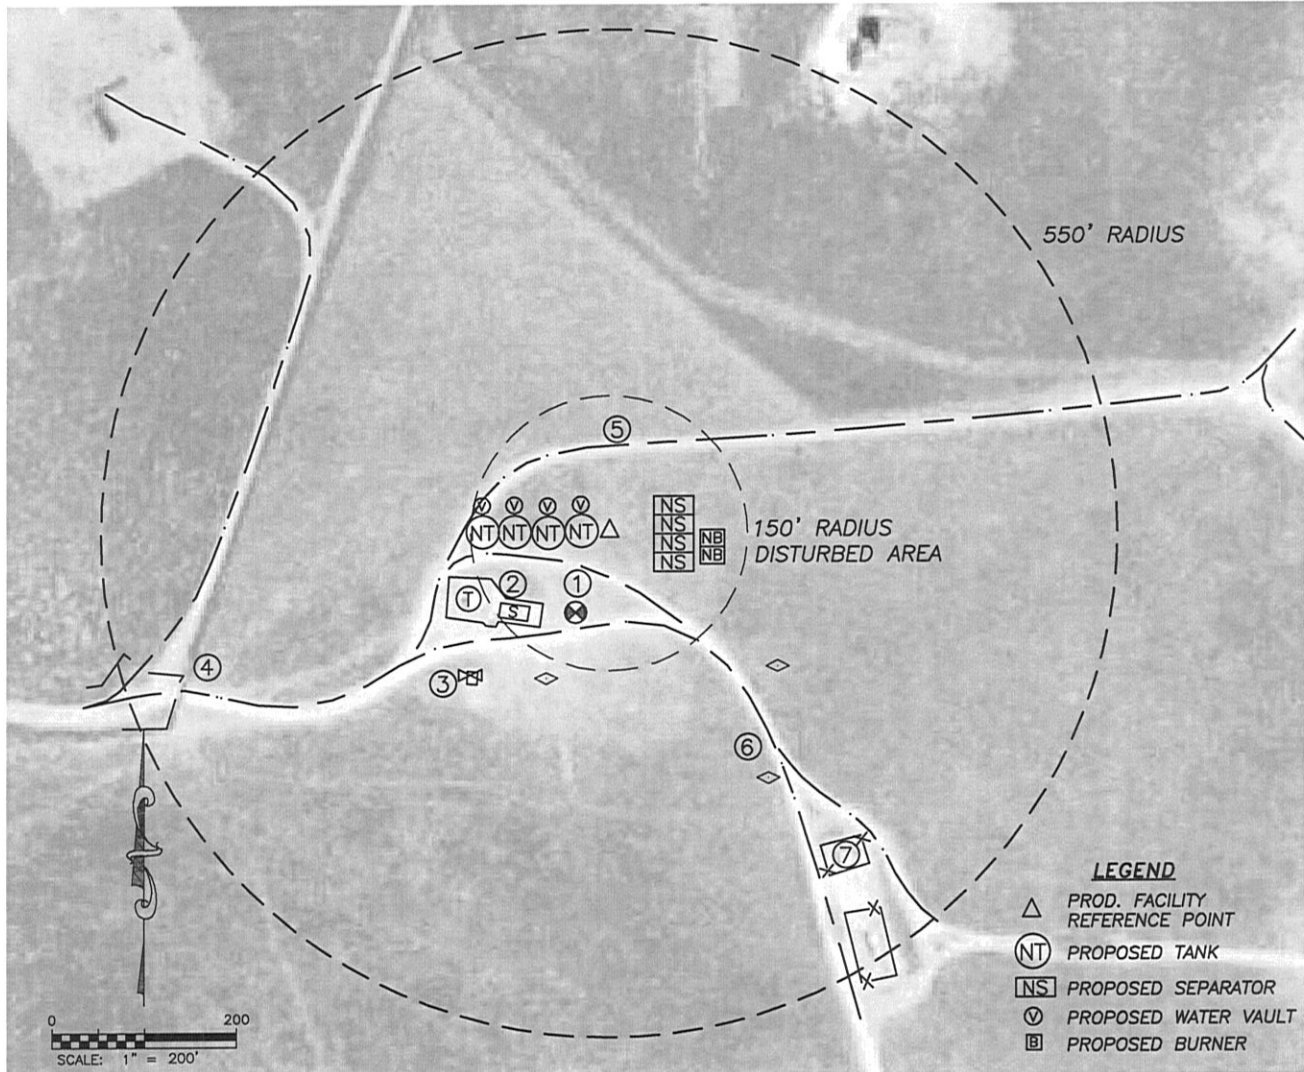

## REFERENCE POINT LOCATION:

LATITUDE: N40.23539°  
LONGITUDE: W104.69302°  
PDOP: 1.8

QUARTER/QUARTER:  
SW4/SW4

NEAREST APPARENT PROP. LINE:  
425'± NE

ASSOCIATED EXISTING WELLS:  
ARISTOCRAT ANGUS 1

ASSOCIATED NEW WELLS:  
REI H08-13D  
REI H08-21D  
REI H08-24D

①

WELL: ARISTOCRAT  
ANGUS 1  
95'± S

②

PROD. FACILITY  
110'± SW

③

VALVE STATION  
215'± SW

④

ENTRANCE GATE  
495'± W

⑤

CENTERLINE  
FIELD ROAD  
95'± N

⑥

GAS LINE  
MARKER  
175'± SW  
230'± SE  
320'± SE

⑦

PROD. FACILITY  
420'± SE