


VISIBLE IMPROVEMENTS

THIS MAP DOES NOT REPRESENT A BOUNDARY SURVEY

SECTION 13
TOWNSHIP 4 NORTH
RANGE 64 WEST

DATE: 05/19/2010

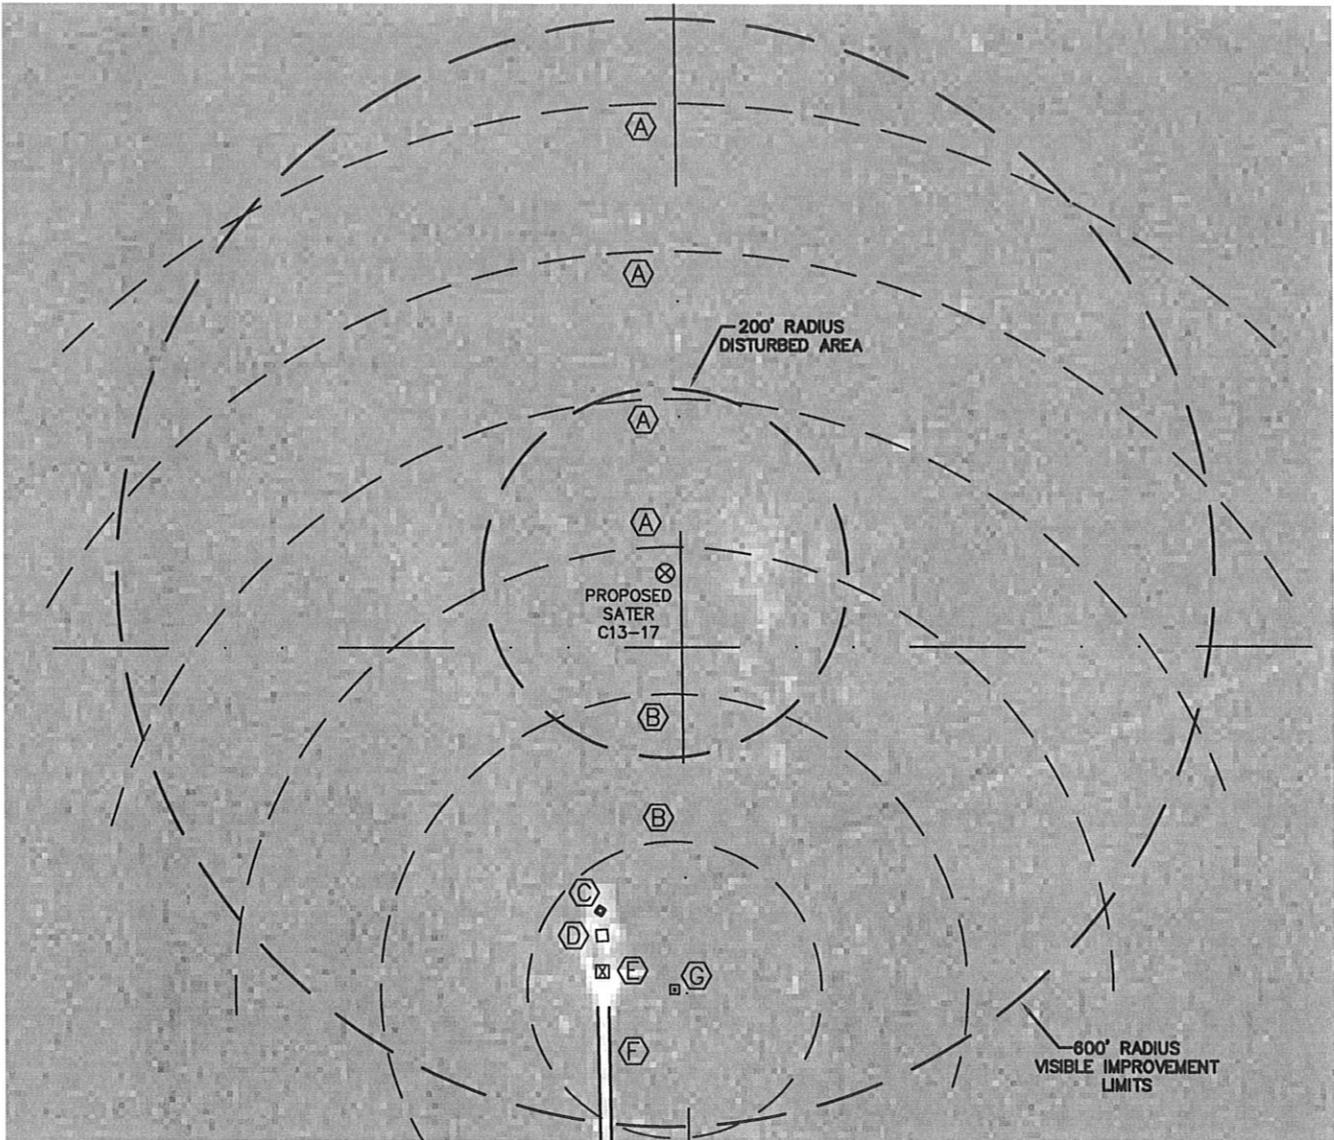

IMPROVEMENTS:

- (A) IRRIGATION WHEEL TRACKS - 28', 188', 348' & 508' NORTH
- (B) IRRIGATION WHEEL TRACKS - 131' & 291' SOUTH
- (C) IRRIGATION WELL SHACK - 369' SOUTH
- (D) CONCRETE PAD - 392' SOUTH
- (E) POWER RISER - 438' SOUTH
- (F) DIRT ACCESS ROAD - 475' SOUTH
- (G) CONCRETE PAD AT PIVOT - 452' SOUTH

NOTICE: According to Colorado law you MUST commence any legal action based upon any defect in this W.L.C. within three years after you first discover such defect. In no event may any action based upon any defect in this W.L.C. be commenced more than ten years from this sold date of the certification shown hereon.

THE NEAREST OVERHEAD POWER LINE IS 1255'+/- NORTH

