


WELL LOCATION FOR MERCHANT ENERGY PARTNERS, LLC

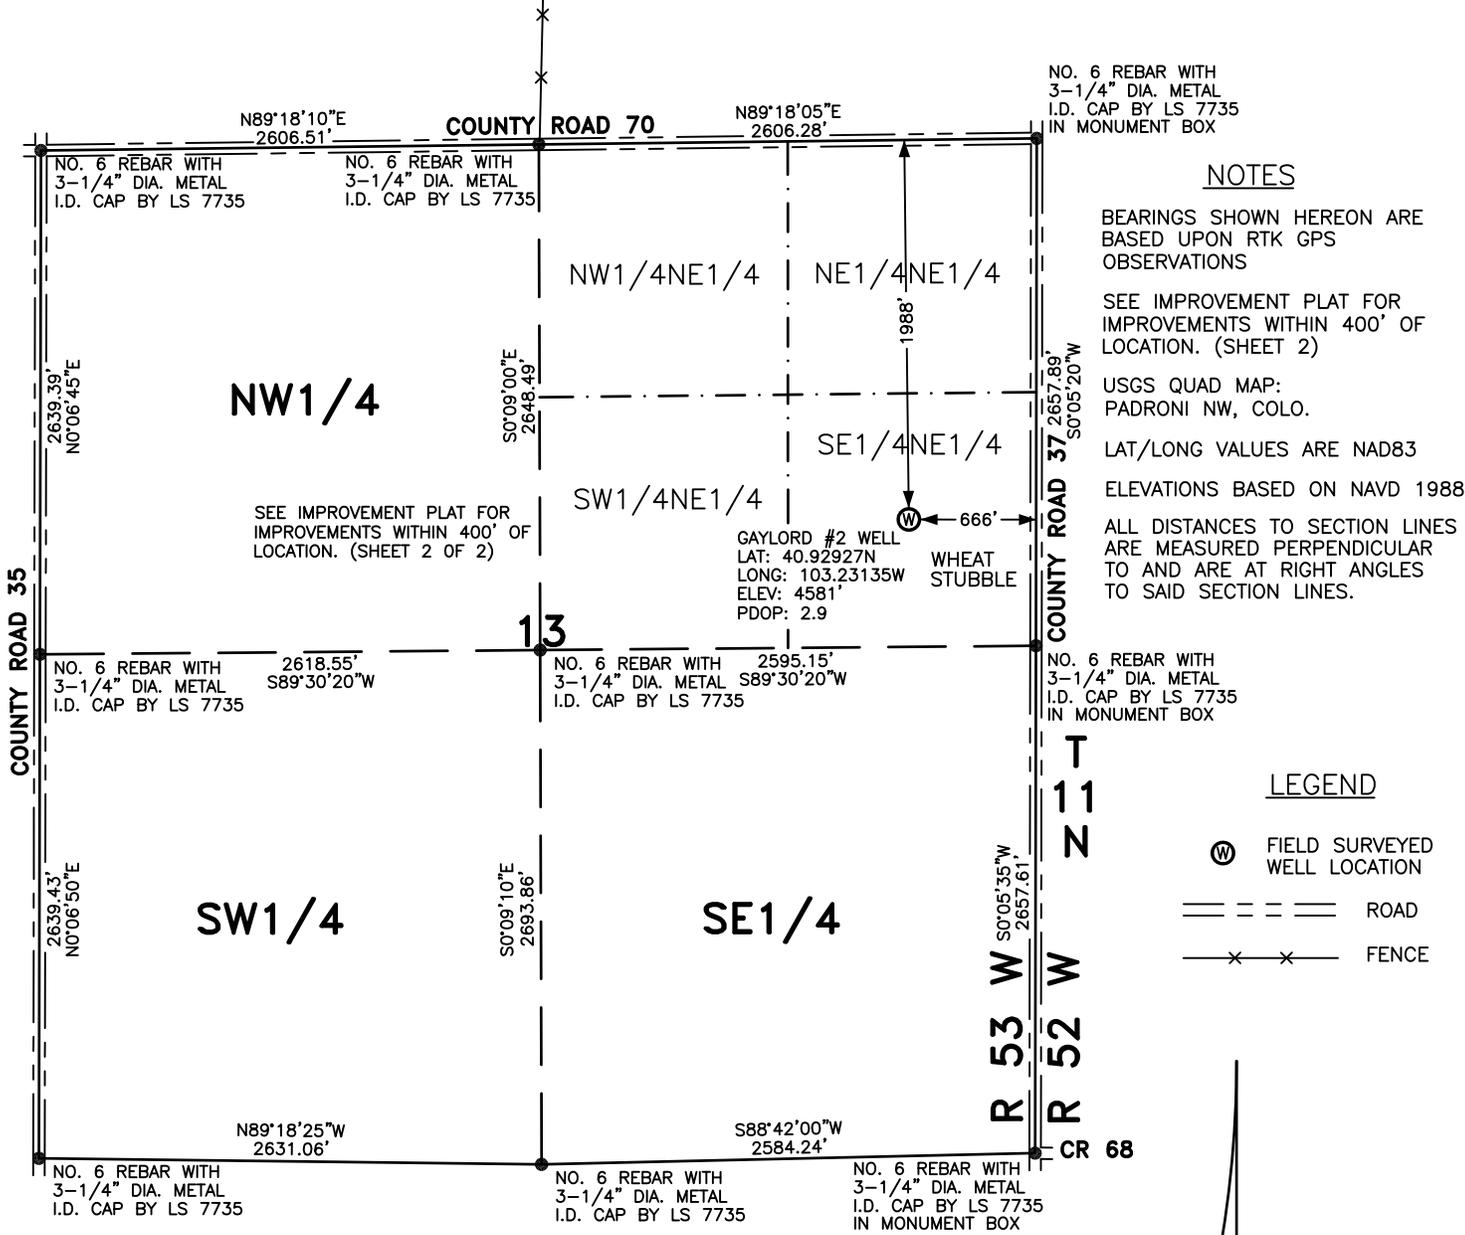

NO. 6 REBAR WITH
3-1/4" DIA. METAL
I.D. CAP BY LS 7735
IN MONUMENT BOX

NOTES

BEARINGS SHOWN HEREON ARE
BASED UPON RTK GPS
OBSERVATIONS

SEE IMPROVEMENT PLAT FOR
IMPROVEMENTS WITHIN 400' OF
LOCATION. (SHEET 2)

USGS QUAD MAP:
PADRONI NW, COLO.


LAT/LONG VALUES ARE NAD83

ELEVATIONS BASED ON NAVD 1988

ALL DISTANCES TO SECTION LINES
ARE MEASURED PERPENDICULAR
TO AND ARE AT RIGHT ANGLES
TO SAID SECTION LINES.

LEGEND

- FIELD SURVEYED WELL LOCATION
- ROAD
- FENCE

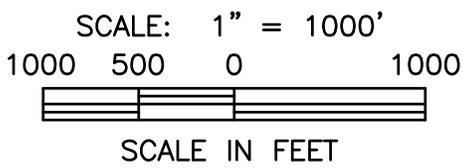

THIS WELL LOCATION PLAT HAS BEEN PREPARED FOR MERCHANT ENERGY PARTNERS, LLC,
TO LOCATE THE GAYLORD #2 WELL BEING 666 FEET FROM THE EAST LINE AND
1988 FEET FROM THE NORTH LINE IN THE SE1/4NE1/4 OF SECTION 13,
TOWNSHIP 11 NORTH, RANGE 53 WEST OF THE 6TH P.M., LOGAN COUNTY, COLORADO.
THE SURFACE ELEVATION AT THIS POINT IS 4581 FEET.
THIS IS NOT A LAND SURVEY PLAT.



LEIBERT-McATEE & ASSOCIATES, INC.		
P.O. BOX 442		615 SOUTH TENTH AVENUE
STERLING, CO 80751		970-522-1960
FIELD DATE: 7-30-10	DWG DATE: 8-9-10	GPS OPERATOR: DARREN VEAL
GAYLORD #2	DWG NO. 1543-09	SHEET 1 OF 2