


NOTES:
 NATURAL GROUND, NO IMPROVEMENTS
 USED FOR GRAZING & PASTURE
 GROUND ELEVATION = 7338.3' NAVD '88 DATUM
 BENCH MARK = USGS BC R268, ELEV. OF 6705.95'
 LAT. = 39°00'10.4"N LAT. = 39.00289°N
 LON. = 107°20'30.2"W LON. = 107.34172°W
 BOTTOM HOLE LOCATION:
 LAT. = 39°00'05.4"N LAT. = 39.00150°N
 LON. = 107°20'30.3"W LON. = 107.34175°W
 NAD 83 DATUM
 PDOP = 2.0 (MAX)
 FIELD DATE : 07/12/10
 DRAWING DATE : 07/27/10

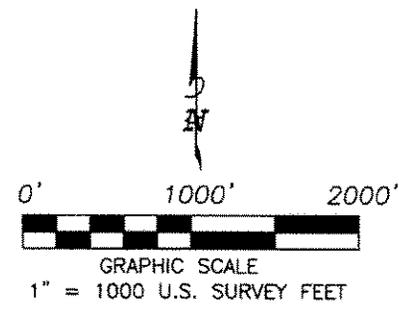

LEGEND

- ⊕ FOUND GLO BRASS CAP ON STEEL POST
- ⊙ FOUND MONUMENT SET BY OTHERS AS NOTED
- ⊠ FOUND ORIGINAL STONE
- WELL HEAD
- (M) MEASURED IN FIELD
- (CALC) CALCULATED LINE
- L 90° SYMBOL
- WC WITNESS CORNER
- E- ELECTRIC POWER LINE


BASIS OF BEARING:

THE LINE FROM THE W1/4 CORNER TO THE NW CORNER OF SECTION 21, TOWNSHIP 12 SOUTH, RANGE 89 WEST, 6TH P.M., WAS ASSUMED TO BEAR N00°19'48"E AS MONUMENTED AND SHOWN HEREON.

CERTIFICATE OF SURVEY:

I, DAVID G. NICEWICZ, A REGISTERED PROFESSIONAL LAND SURVEYOR IN THE STATE OF COLORADO, DO HEREBY CERTIFY THAT THE SURVEY REPRESENTED BY THIS PLAT WAS MADE UNDER MY DIRECTION AND SUPERVISION AND THAT THIS PLAT ACCURATELY REPRESENTS THIS SURVEY.

DAVID G. NICEWICZ, P.L.S. NO. 24965

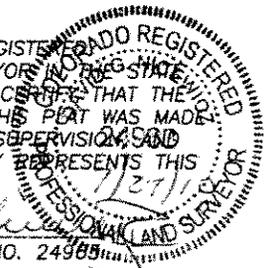

GAS WELL LOCATION

VOLK 12-89-21 #1
 LOCATED IN S. 21, T. 12 S., R. 89 W., 6th P.M.
 GUNNISON COUNTY, COLORADO

E. SCHAAF AND ASSOC., INC. OF DELTA, COLORADO, has in accordance with a request from ERIC SANFORD, for SG INTERESTS I, LTD, determined the bottom hole location of VOLK 12-89-21 #1 to be 1996' FNL & 2431' FWL and the surface hole to be 1491' FNL and 2438' FWL of Section 21, Township 12 South, Range 89 West, of the Sixth Principal Meridian, Gunnison County, Colorado.

SURVEYED BY	DATE	E. SCHAAF AND ASSOC., INC.	
DGN	07/27/10	340 PALMER ST., DELTA, CO. 81416	
DRAWN BY	SCALE	DATE	
DGN	1"=1000'	WE10155SG	SG INT