


WELL LOCATION CERTIFICATE

THIS MAP DOES NOT REPRESENT A BOUNDARY SURVEY

SECTION: 8
TOWNSHIP: 4N
RANGE: 66W

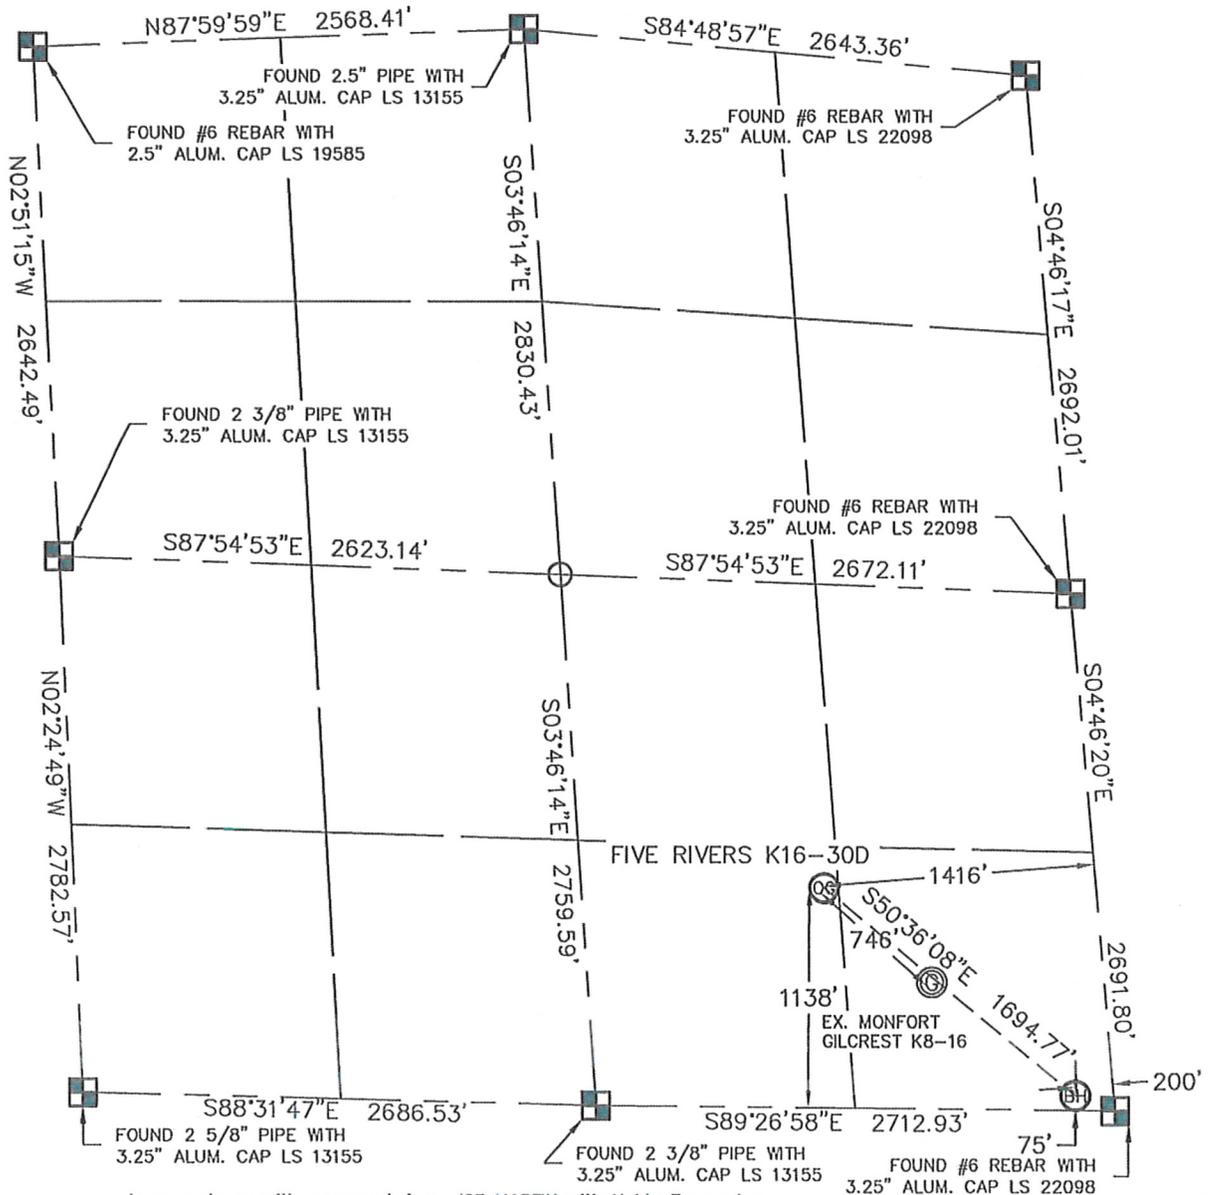

In accordance with a request from JOE MARTIN with Noble Energy Inc. King Surveyors Inc. has determined the surface location of the FIVE RIVERS K16-30D to be 1138' from the SOUTH line and 1416' from the EAST line and the bottom hole to be 75' from the SOUTH line and 200' from the EAST line as measured at right angles from the section line of Section 8, Township 4 North, Range 66 West of the Sixth Principal Meridian, County of Weld, State of Colorado.

I hereby state that this Well Location Certificate was prepared by me, or under my direct supervision, that the fieldwork was completed on 3-1-10, for and on behalf of Noble Energy Inc. That this is not a Land Survey Plat or an Improvement Survey Plat, and that it is not to be relied upon for establishment of fence, building, or other future improvement lines.

NOTE:

- 1) Bearings shown are Grid Bearings of the Colorado State Plane Coordinate System, North Zone, North American Datum 1983/2007. The lineal dimensions as contained herein are based upon the "U.S. Survey Foot."
- 2) Ground elevations are based on an observed GPS elevation (NAVD 1988 DATUM).
- 3) NEAREST EXISTING WELL: MONFORT GILCREST K8-16 746'
- 4) IMPROVEMENTS: See VISIBLE IMPROVEMENTS exhibit for all visible improvements within 400' of well head.
- 5) SURFACE USE: PASTURE

SURFACE LOCATION
LATITUDE: 40.32211N
LONGITUDE: 104.79737W
PDOP: 1.5
ELEV: 4703
1/4, 1/4: SW1/4SE1/4

BOTTOM HOLE
LATITUDE: 40.31913N
LONGITUDE: 104.79271W


NEAREST PROPERTY LINE: 220' NORTH

NOTE

According to Colorado law, you must commence any legal action based upon any defect in this W.L.C. within three years after you discover such defect. In no event, may any action based upon any defect in this survey be commenced more than ten years after the date of the certificate shown hereon. (13-80-105 C.R.S.)


LEGEND

-  = ALIQUOT MONUMENT AS DESCRIBED
-  = CALCULATED POSITION

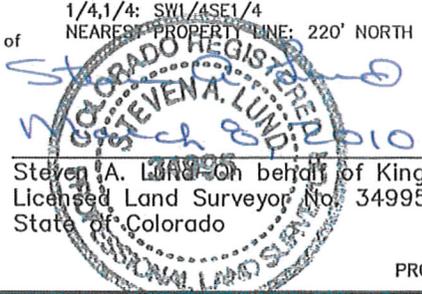

Steven A. Lund on behalf of King Surveyors, Inc.
Licensed Land Surveyor No. 34995
State of Colorado

SECTION: 8
 TOWNSHIP: 4N
 RANGE: 66W

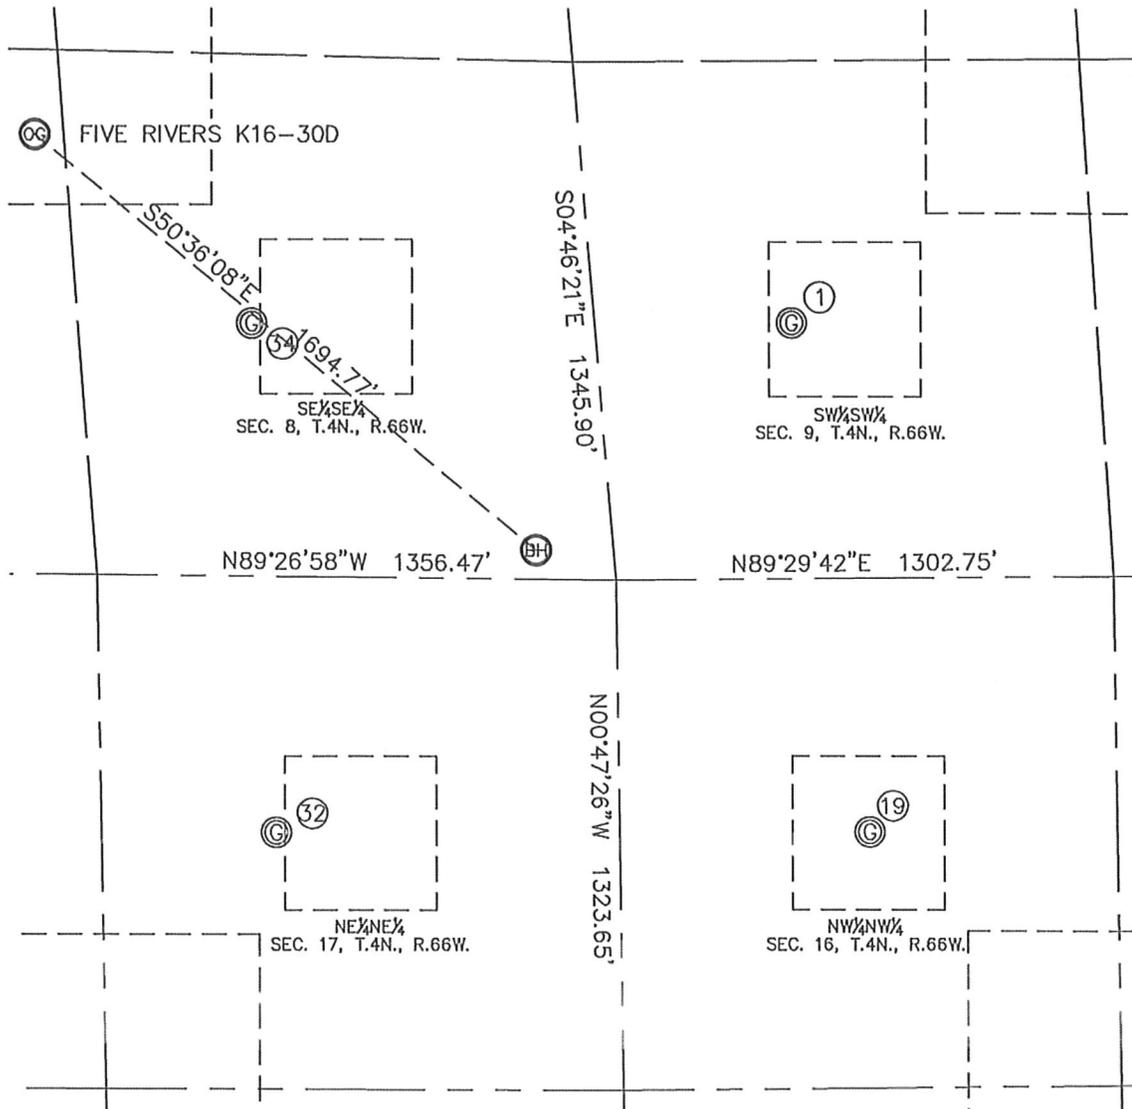

①

MONFORT GILCREST K 9-13
 SW1/4SW1/4
 662' FSL
 514' FWL
 LAT-40.32073N
 LONG-104.79030W
 PDOP: 1.9
 ELEV: 4733'


MONFORT 1-29
 NW1/4NW1/4
 659' FNL
 656' FWL
 LAT-40.31710N
 LONG-104.78960W
 PDOP: 3.3
 ELEV: 4736'


FRONT RANGE 1-17
 NE1/4NE1/4
 665' FNL
 899' FEL
 LAT-40.31713N
 LONG-104.79518W
 PDOP: 2.5
 ELEV: 4734'


MONFORT GILCREST K8-16
 SE1/4SE1/4
 655' FSL
 895' FEL
 LAT-40.32076N
 LONG-104.79537W
 PDOP: 1.7
 ELEV: 4703'

